

OREGON CORNER RESTORATION FORM

COUNTY: Umatilla DATE: 12/22/15

CORNER DESIGNATION: L-21, The West Quarter Corner of Section 13, Township 3 North, Range 34 East, W.M.

PREVIOUS RENEWALS/SURVEYS ETC.: Corner originally established by Currin and Nolin under special contract dated May 4th, 1887. Notes State: Set a charred stake 12 ins. in the ground for ¼ sec. corner.

MONUMENT AND ACCESSORIES FOUND: None. Held the intersection of the centerline of Homly Road North-South with a field berm extending East and West as the best remaining evidence of the corner.

MONUMENT MARKING DETAIL:

T3N R34
1/4
S14|S13
2015
PLS 54657

MONUMENT SET: Sub-base of road has very large rocks starting 12" below surface. Because of this a brass capped piped monument could not be set. At the corner point set a 2" aluminum cap on 5/8"x30" rebar with the top of the cap 10" below gravel road surface. Monument marked as shown in "Monument Marking Detail".

From which:

A silver Deep-1 magnet buried 20" in the ground in a farmed field bears GRID AZIMUTH 39°48', 50.6 feet.

A 5/8"x24" iron rebar with 1 ¼" blue plastic cap marked "Wells Surveying PLS 54657" 2" above ground bears GRID AZIMUTH 100°00', 15.6 feet.

A blue Deep-1 magnet buried 20" in the ground at the edge of the road bears GRID AZIMUTH 216°22', 41.5 feet.

A orange Deep-1 magnet buried 20" in the ground in a farmed field bears GRID AZIMUTH 315°36', 44.3 feet.

Buried bearing object tags with magnets. Wired bearing object tag to rebar. Attached witness post sign to railroad tie marker post 20' +/- East of the Monument.


LOCATION AND COMMENTS: Corner is located at the intersection of the visual centerline of Homly Road North-South and a field berm extending East and West. See Survey Map filed concurrently with this certificate for further information.

FIRM: Wells Surveying
P.O. Box 1696
Pendleton, OR 97801

COMPASS DECLINATION: 18° East

Surveyor's Seal

/3N34L21

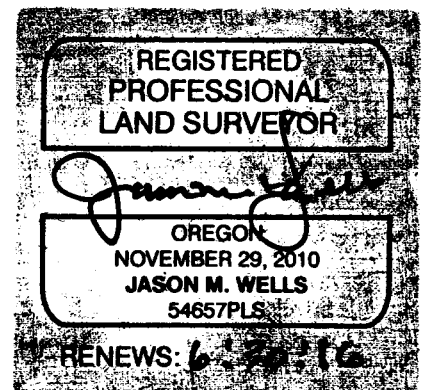

15-125-13