

OREGON CORNER RESTORATION FORM

Section: 1
Township: 3 North
Range: 34 East of the Willamette Meridian
County: Umatilla
Date: 05/13/02

Corner Indexing Information: Township 3N Range 34E Corner Code A-25 (Willamette Meridian)

Additional Identifier: (e.g. BLM designation for the corner, street intersection, plat name, block, lot, etc.)

Northeast Corner Section 1

Oregon Plane Coordinates: N: 775110.873 E: 8712974.138

Zone: North **Order:** second **Datum:** NAD83-91 **Convergence:** 1°25'12.2" **Scale Factor:** 0.99986282

Previous Renewals/Surveys, etc.:

This corner was originally established by Odell and Lewis in 1865 as a charred stake, mound, and pits, per contract no. 110.

Corner re-established in 1915 by Bradley as a stone with bottle. (County Survey Book 2, Page 272)



Wells, in 1997, set a 2 1/2" brass cap on 1" pipe for the corner, with accessories in all quadrants (C.S. 97-141-C)

Monument(s) & Accessories Found (Condition & Source):

At intersection of Pambrun and Rainville Roads, we found a 2 1/2" brass cap 4" deep with accessories noted below.

Monument Set (Procedures & Description):

Monument Detail:

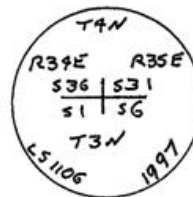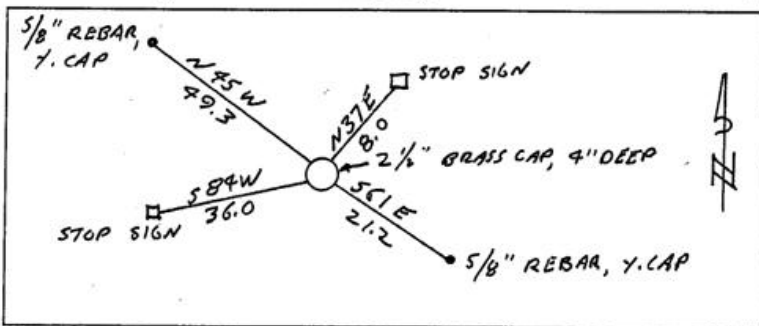

Location & Comments:

Compass Declination:

19° East

Firm/Agency: Tomkins Land Surveying, Inc.
 20 E. Poplar, Suite 204
 Walla Walla WA 99362

Party Chief: PWPT

Notes:

Witness: TP

Surveyor's Seal

REGISTERED
 PROFESSIONAL
 LAND SURVEYOR

Paul W. Tomkins

OREGON
 JULY 26, 1988
 PAUL W. P. TOMKINS
 2360

renews 6/30/04
2/1/03

RECEIVED BY

Umatilla County Surveyor

Date 2-03

Rec'd By KF

No. 03-26-a