

OREGON CORNER RECONSTRUCTION FORM

Section 4 Township 3N Range 36E
 County Umatilla Date: May 19, 2006

Corner Designation: 3N36E13

Corner to sections 3, 4, 9 and 10, T3N, R36E W.M.
 Umatilla County, Oregon.



Condition Report Only
 Not found
 Remonumented
 Unrecorded
 Surveyed in
 Referenced out

Previous Renewals / Surveys, etc.

Corner originally set by George S. Pershin under contract No. 305 dated September 20, 1878. His record reads: A fir, 16" diam. for corner to sections 3, 4, 9 and 10 on NW. hillside from which a Tamarack, 18 in diam. brs. N. 56 E. 36 lks. dist., a Tamarack 5 in diam. brs. S. 34 W. 21 lks. dist., a fir, 36 in diam. brs. N. 70 W., 26 lks. dist.; Mr. Wayne Harris in 1956 under survey Q-543-A says WF found. He also calls for new witness trees S27W 11.5 feet and N27E 35.5 feet.

Monument and Accessories found: (condition and source)

At the corner point I found the decayed remains of the original corner tree. The remains of the NW bearing tree stump and the new SW bearing tree stump by Harris were also still in place.

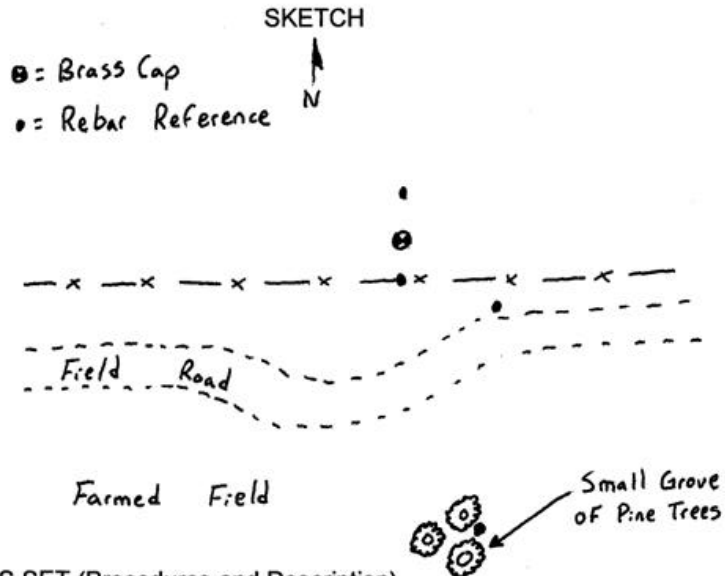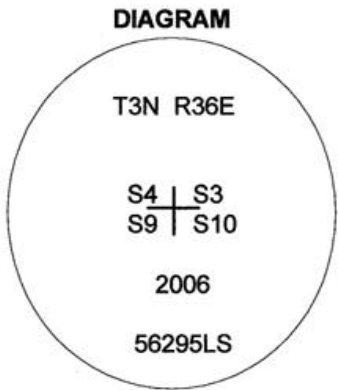

MONUMENT (S) AND ACCESSORIES SET (Procedures and Description)

I set a 1 1/4" x 30" Galvanized Iron Pipe with a 2 1/2" brass cap stamped as shown in the diagram above in the apparent center of the original corner stump.

For references, I set four 5/8" by 24" rebars with 1.25" orange plastic caps stamped WTS and 56295LS as described below:

- an iron rebar bears N4°31'11"W, 17.37 feet;
- an iron rebar bears S8°58'59"W, 22.23 feet under an existing east - west fence;
- an iron rebar bears S53°55'39"E, 71.76 feet;
- an iron rebar bears S12°22'29"E, 193.14 feet;

Bearings given are true. The monument and references were tied using a Trimble 5601 Electronic Total Station.

Location and comments

Compass Declination

Surveyors Seal

RECEIVED BY:
Umatilla County Surveyor
 Date: 7-06
 Rec'd By: KK
 No. 06-472-B

Firm / Agency
 Witness Tree Surveying
 Address
 P.O. Box G
 Pilot Rock, Or. 97868
 Party Chief
 Stephen K. Haddock

REGISTERED
 PROFESSIONAL
 LAND SURVEYOR

Stephen K. Haddock

OREGON
 JULY 9, 2001
 STEPHEN K. HADDOCK
 56295LS

RENEWAL DATE 6-30-07