

USDA-FOREST SERVICE

Index
File No. A-8

CORNER RECORD (SEARCH)


(Ref. FSM 7151.4)

Tract or
Survey No. _____
Cor.
No. _____

T 2N R. 36E R.D. WALLA WALLA County UMATILLA
Merid. WILLAMETTE N.F. UMATILLA State OREGON

CORNER DIAGRAM

INDIAN ALLOTMENT

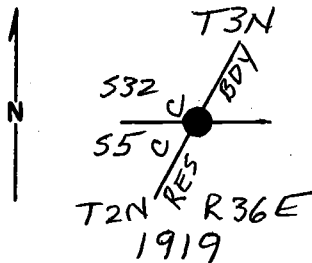

DESCRIBE CORNER MONUMENT FOUND

BRASS CAPPED IRON PIPE LEANING SLIGHTLY SOUTH.
CAP IS MARKED AS SHOWN IN THE CORNER DIAGRAM.

DESCRIBE BEARING TREES OR OTHER OFFICIAL ACCESSORIES FOUND

NONE

PHOTO IDENTIFICATION DATA

Photo No. _____
Filed At. _____
Object Ident. _____
Ident. By _____
Signature

DESCRIBE CORNER LOCATION RELATIVE TO NEAR-BY FEATURES, ALSO HOW TO REACH CORNER

ABOUT 100 FEET NORTH OF A SMALL CREEK.

PLANE COORDINATE POSITION DATA

State _____ Zone _____
X _____
Y _____
Estab. By _____
Agency

Signature Dennis L. Daylord Title PLS 1636 Division S.O. Headquarters APRIL 12, 1991 Date FS-7100-52 (3/88)

CORNER RECORD (PERPETUATION)

MONUMENT: DESCRIBE NEW MONUMENT SET, OR WORK DONE TO PRESERVE EXISTING MONUMENT

ACCESSORIES: DESCRIBE NEW BTLs WITNESS OBJECTS ETC. ESTABLISHED, OR WORK DONE TO PRESERVE EXISTING EVIDENCE

Work Done By _____ Title _____ Date _____ State Registration No. _____
or Agency _____

Certified Cor. Record Prepared? Yes No Filed At: _____ Date _____

REMARKS

Index File No. T. R. M. Tract or Surv. No. Cor.