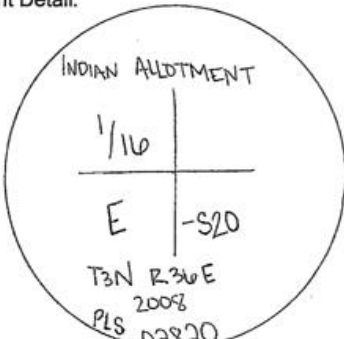
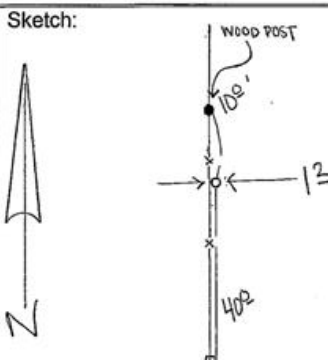
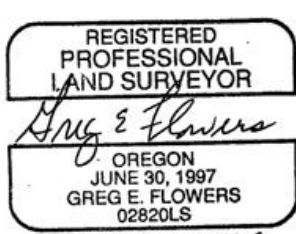


OR. ON PUBLIC LAND CORNER REPORT / RESTORATION REPO...
 Umatilla County Surveyor's Office

SECTION 19	TOWNSHIP 3N	RANGE 36E
COUNTY: Umatilla		DATE 6/20/08
CORNER DESIGNATION: O-6 Northwest 1/16 corner of Section 20		(Please check one) <input type="checkbox"/> Condition Report Only <input type="checkbox"/> Not Found <input type="checkbox"/> Renewed <input type="checkbox"/> Unrecorded <input checked="" type="checkbox"/> Surveyed In <input type="checkbox"/> Referenced Out
Previous Renewals / Surveys, etc. This corner was originally set by U.S. Indian Services Surveyor C.E. Redfield in 1919		
Monument(s) & Accessories Found: (Condition & Source) None found this area has been farmed		
Monument Detail: 	Sketch: 	
Monument Set (Procedures and Description): at the surveyed position on the prolongation of a line from the found 1/16 corner on the East line of Section 20 through the found center North 1/16 corner of Section 20 set a 1/2"x30" galvanized iron pipe with a 2" brass cap 18 inches in the ground 1.2 feet east of a North-South fence.		
New Accessories: Placed a bearing tree sign on a wood fence post 10 feet North of the corner and on a Railroad Tie fence post 40 feet south of the corner.		
Location & Comments: The corner is located on a grassy, open, gentle south slope 1.2 feet east of a North-South Fence		Compass Declination: 19° East
Firm / Agency USKH Inc. Address: 5 N. Colville St. Walla Walla, WA 99362 Party Chief Damon Locke		SURVEYOR'S SEAL 
Notes		
Witness Levi Blackwolf		

RENEWS 12/3/09

6/30/08