

Form 874-9

U. S. DEPARTMENT OF AGRICULTURE
FOREST SERVICE

NATIONAL FOREST

CORNERS OF THE PUBLIC SURVEY

T. 3N. R. 37E. Mer.

1/4 Sec.

Corner common to Sections

2, and 3

DESCRIPTION OF CORNER

Corner consists of a stake

Dimension above ground 4 inches.
Sketch grooves, letters, figures, or notches, on proper face or edge.

CARDINAL POSITION

DIAGONAL POSITION

N	W	S	E

NW	SW	SE	NE

Mound of _____ is located _____

Pits are located _____

Sketch markings of Bearing Trees (or Rocks) in proper box and fill blanks below, giving bearings from Corner to Trees and Distances in Links.

1/4 S-2

1/4 S-3

--

--

B.T.

B.T.

--

--

Species W.F. W.F.

Diameter 3.0" 2.7"

Bearing N.22E. N.30W.

Distance 15' 8'

Do you believe this to be a genuine Land Office Corner? Yes

If not, why? _____

Albert Baker

Signature

Dist. Ranger

5-11-40

Date


Title

8-3027

T. 3N. R. 37 E. Mer.

8-3027

(Make sketch of topography near Corner.)

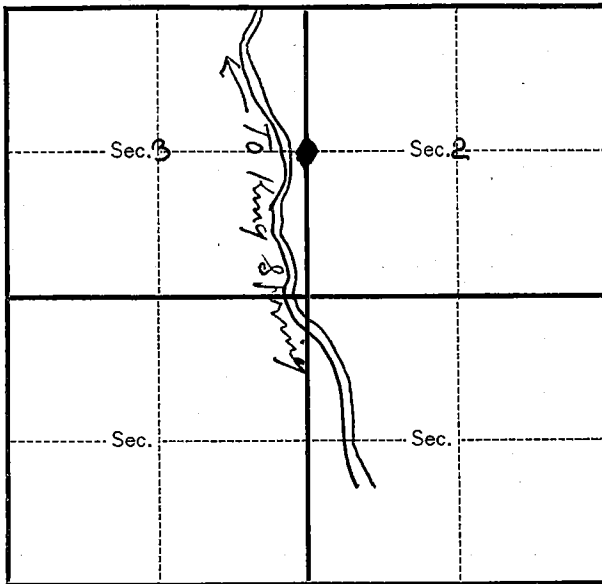

Metal Location Poster is on a N. Larch
tree 4 inches diameter, on the north
side of Corner
from which this Corner bears S. 8° - W
1/2 chains distant.

Give any further facts which will aid in finding this
Corner again.

Corner is medium heavy
second growth timber.
The road leading from
King Spring poster 200
feet west of corner.

A.B.

USDA-FOREST SERVICE

Index

File No. C-17

CORNER RECORD (SEARCH)

Tract or Survey No. _____ Cor. No. _____


T 3 N R. 37 E

R.D. WALLA WALLA (Ref. FSM 7151.4) County UMATILLA

Merid. Will.

N.F. UMATILLA State OR.

CORNER DIAGRAM

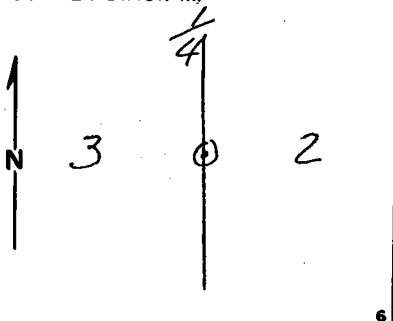

DESCRIBE CORNER MONUMENT FOUND

NONE

DESCRIBE BEARING TREES OR OTHER OFFICIAL ACCESSORIES FOUND

NONE

PHOTO IDENTIFICATION DATA

Photo No. 616140 1280-118

Filed At. _____

Object Ident. PRECISE

Ident. By Victor McInd
Signature

DESCRIBE CORNER LOCATION RELATIVE TO NEAR-BY FEATURES, ALSO HOW TO REACH CORNER

LIES ON S.W. SLOPE, ABOUT 150' S.W. OF AN OPEN RIDGE RUNNING N.W.

PLANE COORDINATE POSITION DATA

State _____ Zone _____

X _____

Y _____

Estab. By _____
Agency

Signature Victor McInd Title LS

Division _____ Headquarters _____

Date 6-26-86

FS-7100-52 (3/68)

CORNER RECORD (PERPETUATION)

MONUMENT: DESCRIBE NEW MONUMENT SET, OR WORK DONE TO PRESERVE EXISTING MONUMENT

AT PROPORTIONED LOCATION I SET A 2" x 30" AL. PIPE WITH 2 1/2" AL. CAP, MKD. →
IN A MOUND OF STONE.

T3N R37E
1/4
S3 | S2
1986
RLS 934

ACCESSORIES : DESCRIBE NEW BT'S WITNESS OBJECTS ETC. ESTABLISHED, OR WORK DONE TO PRESERVE EXISTING EVIDENCE

13" FIR, SCRIBED "1/4 S 3 BT" BEARS N50 1/4 W, 18.0 FT.

16" FIR, SCRIBED "1/4 S 2 BT" BEARS N76 3/4 E, 19.3 FT.

SET STEEL POSTS 3 FT. N. AND 3 FT. S. OF COR., WITH SIGNS 54-2 + 54-9

PAINTED RED BAND AROUND BOTH BT'S

ATTACHED SIGN 54-4 TO BACK OF BT'S AND SIGN 54-3 TO FRONT OF BT'S.

Work Done By V. McLIND Title LS Date 6-26-86 State Registration No. or Agency 934 10

Certified Cor. Record Prepared ? Yes No Filed At: _____ Date _____ 11

REMARKS

Index File No. C-17 T. 3N R. 37E M. WILL. Tract or Surv. No. _____ Cor. _____ 12