

USDA-FOREST SERVICE

Index  
File No. WB 928A

**CORNER RECORD (SEARCH)**

(Ref. FSM 7151.4)

Tract or  
Survey No. \_\_\_\_\_ Cor.  
No. \_\_\_\_\_


T 3N R. 37E

R.D. WALLA WALLA County UMATILLA

Merid. WILLAMETTE

N.F. UMATILLA State OREGON

**CORNER DIAGRAM**

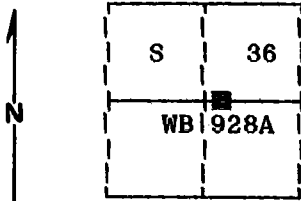

**DESCRIBE CORNER MONUMENT FOUND**

Corner not previously established.

**DESCRIBE BEARING TREES OR OTHER OFFICIAL ACCESSORIES FOUND**

No accessories previously established.

**PHOTO IDENTIFICATION DATA**

Photo No. \_\_\_\_\_  
Filed At. \_\_\_\_\_  
Object Ident. \_\_\_\_\_  
Ident. By \_\_\_\_\_  
*Signature*

**DESCRIBE CORNER LOCATION RELATIVE TO NEAR-BY FEATURES, ALSO HOW TO REACH CORNER**

Corner falls on very steep brushy timbered East slope approximately 400 feet West of draw and 1000 feet North of the 3150-045 road.

**PLANE COORDINATE POSITION DATA**

State \_\_\_\_\_ Zone \_\_\_\_\_  
X \_\_\_\_\_  
Y \_\_\_\_\_  
Estab. By \_\_\_\_\_  
*Agency*

*Signature*

Title \_\_\_\_\_ Division \_\_\_\_\_ Headquarters \_\_\_\_\_ Date \_\_\_\_\_

FS-7100-52 (3/68)

2

3

4

5

**CORNER RECORD (PERPETUATION)**

**MONUMENT: DESCRIBE NEW MONUMENT SET, OR WORK DONE TO PRESERVE EXISTING MONUMENT**

WB 928A

Set a 2 1/2"x30" aluminum pipe with aluminum cap marked as shown:  
Pipe is set 28 inches in the ground.

1991  
OPLS 644

9

**ACCESSORIES : DESCRIBE NEW BT's WITNESS OBJECTS ETC. ESTABLISHED, OR WORK DONE TO PRESERVE EXISTING EVIDENCE**

**New BTs:**

A 12 inch diam. Douglas Fir bears N53°E, 30.6 feet marked WB 928A BT  
A 13 inch diam. Douglas Fir bears S85°W, 15.4 feet marked WB 928A BT

Attached Bearing Tree and Land Survey Monument signs to the BT  
Set a steel fencepost approximately 5 feet West with  
Land Survey Monument and Wilderness Boundary signs attached.

10

Work Done By: <u>D.I. Griffith</u>	Title: <u>Surveyor</u>	Date: <u>10-7-92</u>	State Registration No. or Agency: <u>OPLS 644</u>	10
Certified Cor. Record Prepared ? Yes <input type="checkbox"/> No <input checked="" type="checkbox"/>	Filed At: <u>Umatilla Co. Surveyor Off.</u>	Date: <u>10-92</u>		11

**REMARKS**

Witnesses: Jeff Petersen, Rick Robinson, Jim Bennett and John Osterman

12

Index File No.	T.	R.	M.	Tract or Surv. No.	Cor.	13
----------------	----	----	----	--------------------	------	----