


USDA-FOREST SERVICE

Index File No. T-17 CORNER RECORD (SEARCH) (Ref. FSM 7151.4) Tract or Survey No. _____ Cor. No. _____
 T 3N R. 37E R.D. WALLA WALLA County UMATILLA
 Merid. WILLAMETTE N.F. UMATILLA State OREGON

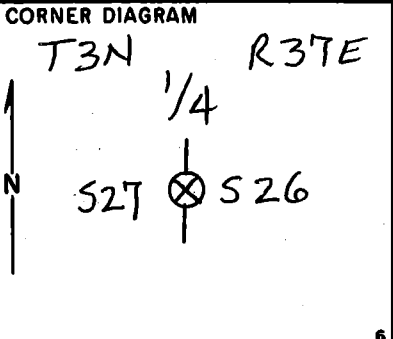

DESCRIBE CORNER MONUMENT FOUND

WINDFALL IS OVER CORNER AREA, STONE IS PROBABLY UNDER LOG.

DESCRIBE BEARING TREES OR OTHER OFFICIAL ACCESSORIES FOUND

ORIGINAL 12" FIR IS NOW A 20" DOUGLAS-FIR WITH A SINGLE HEALED BLAZE. BEARS N88 1/2° E, 11.22 FEET.
 ORIGINAL 10" FIR IS DOWN & DECAYED, ROOT HOLE BEARS N 4 1/2° W, 7.3 FEET. (NO MARKS LEFT)

PHOTO IDENTIFICATION DATA

Photo No. _____
 Filed At. _____
 Object Ident. _____
 Ident. By _____
 Signature _____

DESCRIBE CORNER LOCATION RELATIVE TO NEAR-BY FEATURES, ALSO HOW TO REACH CORNER

PLACED B.T. SIGN ON LIVE BEARING TREE.

PLANE COORDINATE POSITION DATA

State _____ Zone _____
 X _____
 Y _____
 Estab. By _____
 Agency _____

Signature Dennis L. Hayford Title _____ Division PLS 1636 Headquarters S.O. Date 4/19/94 FS-7100-52 (3/88)

CORNER RECORD (PERPETUATION)

MONUMENT: DESCRIBE NEW MONUMENT SET, OR WORK DONE TO PRESERVE EXISTING MONUMENT

ACCESSORIES : DESCRIBE NEW BT'S WITNESS OBJECTS ETC. ESTABLISHED, OR WORK DONE TO PRESERVE EXISTING EVIDENCE

Work Done By. _____ **Title** _____ **Date** _____ **State Registration No.** _____
or Agency _____

Certified Cor. Record Prepared ? Yes No **Filed At:** _____ **Date** _____

REMARKS

Index File No. _____ **T.** _____ **R.** _____ **M.** _____ **Tract or Surv. No.** _____ **Cor.** _____