

Index

File No.

T. 3 N. R. 38 E.

Merid. WILLAMETTE

CORNER RECORD (SEARCH)

(Ref. FSM 7151.4)

R.D. WALLA-WALLA

N.F. UMATILLA

County UNION

State OREGON


Tract or

Survey No. **NF UMATILLA**

Cor.

No. **AP-458**

CORNER DIAGRAM

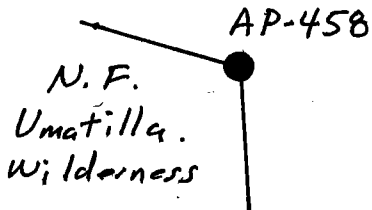

DESCRIBE CORNER MONUMENT FOUND

NONE

DESCRIBE BEARING TREES OR OTHER OFFICIAL ACCESSORIES FOUND

NONE

PHOTO IDENTIFICATION DATA

Photo No.:

Filed At.:

Object Ident.:

Ident. By:

Signature

DESCRIBE CORNER RELATIVE TO NEAR-BY FEATURES, ALSO HOW TO REACH CORNER

The corner is located on a spur ridge at an elevation of 5000 feet.

PLANE COORDINATE POSITION

State: OREGON Zone: NORTH

X: 2,690,133.461 meters

Y: 234,002.023 meters

Datum: NAD83(1991)

Signature

D. Schlaich

Title

Land Surveyor

Division

Headquarters

S.O.

Date

09/1994

FS-7100-52 (3/68)

CORNER RECORD (PERPETUATION)

MONUMENT: DESCRIBE NEW MONUMENT SET, OR WORK DONE TO PRESERVE EXISTING MONUMENT

Set a 5/8" by 24" rebar, with a 3 1/4" aluminum cap, flush with the ground, mkd. "NFU WILDERNESS AP-458 ELEV 5000
RLS 2308 1994"

ACCESSORIES : DESCRIBE NEW BT's WITNESS OBJECTS ETC. ESTABLISHED, OR WORK DONE TO PRESERVE EXISTING EVIDENCE

Work Done By **D. Schlaich**

Title **Land Surveyor**

Date **09/1994**

State Registration No.
or Agency

Certified Cor. Record Prepared ? **NO**

Filed At

Date

REMARKS

Index File No.

T.

3 N.

R.

38 E.

M.

W.M.

Tract or Survey No.

NF UMATILLA

Cor.

AP-458