

USDA-FOREST SERVICE

Index

File No.

T. 3 N. R. 38 E.

Merid. WILLAMETTE

CORNER RECORD (SEARCH)

(Ref. FSM 7151.4)

R.D. Walla Walla

N.F. UMATILLA

Tract or

Survey No. NF Umatilla


Cor.

No. AP-509

County UMATILLA

State OREGON

CORNER DIAGRAM

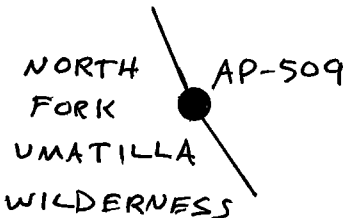

DESCRIBE CORNER MONUMENT FOUND

NONE

DESCRIBE BEARING TREES OR OTHER OFFICIAL ACCESSORIES FOUND

NONE

PHOTO IDENTIFICATION DATA

Photo No.:

Filed At.:

Object Ident.:

Ident. By:

Signature

DESCRIBE CORNER RELATIVE TO NEAR-BY FEATURES, ALSO HOW TO REACH CORNER

From the jct. of Oregon Highway 204 and the most northerly access of the Woodland Park Snow Park, descend S. 38° W, approx 700 feet to the corner which is on the 5000 foot contour.

PLANE COORDINATE POSITION

State: Oregon Zone: North

X: 2,629,652.90'

Y: 762,969.88'

Datum: NAD1927

Signature

D. Schlaich

Title

Land Surveyor

Division

Headquarters

S.O.

Date

06/1996

FS-7100-52 (3/68)

CORNER RECORD (PERPETUATION)

MONUMENT: DESCRIBE NEW MONUMENT SET, OR WORK DONE TO PRESERVE EXISTING MONUMENT

Set at an elevation of 5000 feet a 5/8" by 36" rebar, with a 3 1/4" aluminum cap, flush with the ground, mkd. "NFU WILDERNESS AP-509 RLS 2308 1996"

ACCESSORIES : DESCRIBE NEW BT's WITNESS OBJECTS ETC. ESTABLISHED, OR WORK DONE TO PRESERVE EXISTING EVIDENCE

14" Western Larch, S 7 1/2° W, 2.6 feet, mkd. "WB/509" "BT".

7" Western Larch, N 9 1/2° W, 10.4 feet, mkd. "WB/509" "BT".

BT's are double blazed and have a 3/4" brass washer mkd. "RLS 2308" nailed to the lower blaze by the "BT" scribing.

Work Done By **D. Schlaich**

Title **Land Surveyor**

Date **06/1996**

State Registration No.
or Agency

Certified Cor. Record Prepared ? **NO**

Filed At:

Date

REMARKS

Index File No.

T.

3 N.

R.

38 E.

M.

W.M.

Tract or Survey No.

NF Umatilla

Cor.

AP-509