

Index

File No.

T. 3 N. R. 38 E.

Merid. WILLAMETTE

CORNER RECORD (SEARCH)

(Ref. FSM 7151.4)

R.D. Walla Walla

N.F. UMATILLA

Tract or

Survey No. **NF Umatilla**


County **UMATILLA**

State **OREGON**

Cor.

No. **AP-495**

CORNER DIAGRAM

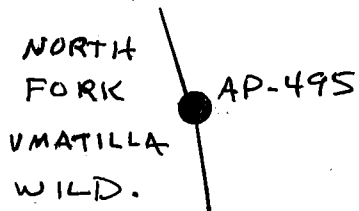

DESCRIBE CORNER MONUMENT FOUND

NONE

DESCRIBE BEARING TREES OR OTHER OFFICIAL ACCESSORIES FOUND

NONE

PHOTO IDENTIFICATION DATA

Photo No.:

Filed At.:

Object Ident.:

Ident. By:

Signature

DESCRIBE CORNER RELATIVE TO NEAR-BY FEATURES, ALSO HOW TO REACH CORNER

From the jct. of Oregon Highway 204 and 3700-070 (Umatilla Breaks Viewpoint) descend S. 11° E., approx. 1030 feet to the corner which is located on the 5000 foot contour.

PLANE COORDINATE POSITION DATA

State: Oregon Zone: North

X: 2,628,915.48'

Y: 764,851.28'

Datum: NAD1927

Signature

D. Schlaich

Title

Land Surveyor

Division

Headquarters

S.O.

Date

06/1996

FS-7100-52 (3/68)

CORNER RECORD (PERPETUATION)

MONUMENT: DESCRIBE NEW MONUMENT SET, OR WORK DONE TO PRESERVE EXISTING MONUMENT

Set at an elevation of 5000 feet a 5/8" by 36" rebar, with a 3 1/4" aluminum cap, flush with the ground, mkd.
"NFU WILDERNESS AP-495 RLS 2308 1996"

ACCESSORIES : DESCRIBE NEW BT's WITNESS OBJECTS ETC. ESTABLISHED, OR WORK DONE TO PRESERVE EXISTING EVIDENCE

14" White Fir, S. 41 1/2° E., 9.2 ft., mkd. "WB/495" "BT".

13" Grand Fir, N. 80 1/2° W., 17.2 ft., mkd. "WB/495" "BT".

BT's are double blazed and have a 3/4" brass washer mkd. "RLS 2308" nailed to the lower blaze by the "BT" scribing.

Work Done By **D. Schlaich**

Title **Land Surveyor**

Date **06/1996**

State Registration No.
or Agency

Certified Cor. Record Prepared ? **NO**

Filed At:

Date

REMARKS

Index File No.

T.

3 N.

R.

38 E.

M.

W.M.

Tract or Survey No.

NF Umatilla

Cor.

AP-495