

Index

File No.

T. 3 N. R. 38 E.

Merid. WILLAMETTE

CORNER RECORD (SEARCH)

(Ref. FSM 7151.4)

R.D. Walla Walla

N.F. UMATILLA

Tract or

Survey No. NF Umatilla


County UMATILLA

State OREGON

Cor.

No. AP-347

CORNER DIAGRAM

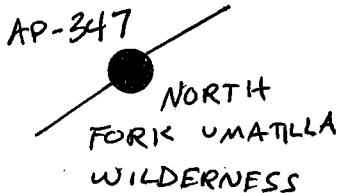

DESCRIBE CORNER MONUMENT FOUND

NONE

DESCRIBE BEARING TREES OR OTHER OFFICIAL ACCESSORIES FOUND

NONE

PHOTO IDENTIFICATION DATA

Photo No.:

Filed At.:

Object Ident.:

Ident. By:

Signature

DESCRIBE CORNER RELATIVE TO NEAR-BY FEATURES, ALSO HOW TO REACH CORNER

From the jct. of F.S. roads 3719 and 3719-050 travel southeasterly on road 3719-050 approx. 0.4 miles to the end of the road. From the end of the road walk S. 2° W., 600 feet to the corner.

PLANE COORDINATE POSITION

State: Oregon Zone: North

X: 2,615,881.80'

Y: 768,839.86'

Datum: NAD1927

Signature

D. Schlaich

Title

Land Surveyor

Division

Headquarters

S.O.

Date

07/1996

FS-7100-52 (3/68)

CORNER RECORD (PERPETUATION)

MONUMENT: DESCRIBE NEW MONUMENT SET, OR WORK DONE TO PRESERVE EXISTING MONUMENT

Set at an elevation of 4800 feet a 5/8" by 24" rebar, with a 3 1/4" aluminum cap, 22" in the ground, mkd. "NFU WILDERNESS AP-347 RLS 2308 1996"

ACCESSORIES : DESCRIBE NEW BT's WITNESS OBJECTS ETC. ESTABLISHED, OR WORK DONE TO PRESERVE EXISTING EVIDENCE

8" Douglas Fir, S 9° W, 12.1 feet, mkd. "WB/347" "BT".

7" Ponderosa Pine, S 69 1/2° W, 21.2 feet, mkd. "WB/347" "BT".

Work Done By **D. Schlaich**

Title **Land Surveyor**

Date **07/1996**

State Registration No.
or Agency

Certified Cor. Record Prepared? **NO**

Filed At:

Date

REMARKS

Index File No.

T.

3 N.

R.

38 E.

M.

W.M.

Tract or Survey No.

NF Umatilla

Cor.

AP-347