

CERTIFIED RECORD OF LAND CORNER MONUMENTATION

C - 21
DIAGRAM

History of original corner establishment:

The original corner was established by George S. Pershin on September 8, 1879, under GLO contract No. 332, as follows:

Set a basalt stone, 20" x 12" x 4", on east face of bluff for 1/4 section corner.

T3S R30E
1/4
S2|S1
PLS 1636
2003

Original corner evidence recovered:

Found the original corner stone solidly set, but tipped to the east, with one other stone alongside. The corner stone is 23" x 17" x 5" and is plainly marked "1/4" on the west face.

Monument and accessories established to perpetuate the original position of this corner:

In place of the original corner stone, I set a 1" x 30" flared, galvanized iron pipe 27" into the ground. A 2 1/2" brass cap attached to the top of the pipe is marked as shown in the diagram above. I bury the corner stone along the south side of the pipe and build a mound of stones around the pipe, from which:

A 5/8" x 36" iron rod set 35" into the ground with a 3/4" brass washer, marked "PLS 1636 NE", attached at ground level, bears N72° 30' E, 81.1 feet.

A 5/8" x 24" iron rod set 23" into the ground with a 3/4" brass washer, marked "PLS 1636 SE", attached at ground level, bears S50° 30' E, 94.0 feet.

A wire fence projecting east and west, bears South, 80.0 feet.


A 5/8" x 24" iron rod set 23" into the ground with a 3/4" brass washer, marked "PLS 1636 SW", attached at ground level, bears S49° W, 83.4 feet.

A 5/8" x 36" iron rod set 35" into the ground with a 3/4" brass washer, marked "PLS 1636 NW", attached at ground level, bears N64° 30' W, 106.8 feet.

I hereby certify this corner point was perpetuated as hereon described on May 23, 2003.

Magnetic declination set in compass: 15° E.

NAD '83 UTM Zone 11 position: 5022163N 339973E (plus or minus two meters).

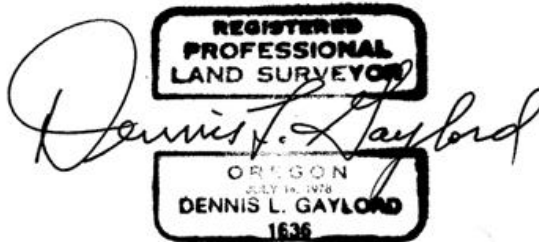

Renews June 30, 2003

Recorded at the office of County Surveyor, County of Umatilla, State of Oregon, on:

RECEIVED BY
Umatilla County Surveyor
Date 9-03
Rec'd By KK
No. 03-259-R