


CERTIFIED RECORD OF LAND CORNER MONUMENTATION

N - 25
DIAGRAM

History of original corner establishment:

The original corner was established by George Williams on September 28, 1872, under GLO contract No. 176, as follows:

Set a stone, 16" x 6" x 5", on east slope of hill for corner to sections 13, 24, 18 and 19.

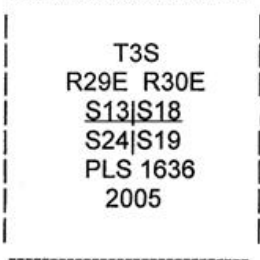

Original corner evidence recovered:


Found the original corner stone solidly set on the south edge of a mound of stones. The original corner stone is 16" x 8" x 6" and is plainly marked with three notches on the north edge and three notches on the south edge .

Monument and accessories established to perpetuate the original position of this corner:

In place of the corner stone, I set a 1" x 30" flared, galvanized iron pipe 23" into the ground. I bury the corner stone along the west side of the pipe and build a mound of stones around the pipe. A 2 1/2" brass cap attached to the top of the pipe is marked as shown in the diagram above, from which:

- A 5/8" x 24" iron rod set 23" into the ground with a 3/4" brass washer, marked "PLS 1636 18", attached at ground level, bears N53° E, 69.4 feet.
 - A 5/8" x 18" iron rod set 17" into the ground with a 3/4" brass washer, marked "PLS 1636 19", attached at ground level, bears S45° 30' E, 70.8 feet.
 - A 5/8" x 18" iron rod set 17" into the ground with a 3/4" brass washer, marked "PLS 1636 24", attached at ground level, bears S79° 30' W, 70.6 feet.
 - A 5/8" x 24" iron rod set 23" into the ground with a 3/4" brass washer, marked "PLS 1636 13", attached at ground level, bears N32° 30' W, 76.0 feet.
- This corner marks a point on the Morrow - Umatilla County line.

I hereby certify the above corner point was perpetuated as hereon described on February 10, 2005. Magnetic declination set in compass: 15° E.
NAD '83 UTM Zone 11 position: 5018435N, 331706E (plus or minus two meters).

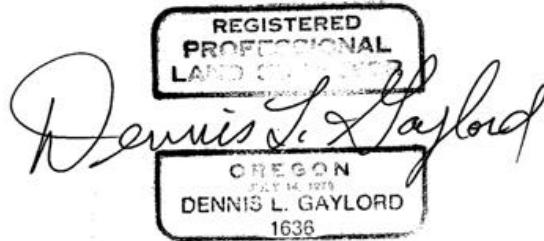

Renews June 30, 2005

Recorded at the office of County Surveyor, County of Morrow, State of Oregon, on:

RECEIVED BY
Umatilla County Surveyor
Date 2-05
Rec'd by KK
No. 05-30-R