

OREGON CORNER RESTORATION FORM

Section 27 Township 3S Range 31E
 County Umatilla Date: June 23, 2015

Corner Designation: 3S31R15

Condition Report Only
 Not found
 Remonumented
 Unrecorded
 Surveyed in
 Referenced out

Quarter corner common to sections 22 and 27, T3S, R31E, W.M., Umatilla County, Oregon.


Previous Renewals / Surveys, etc.

Corner originally set by George S. Pershin under contract No. 319 dated March 26, 1879. His record reads: Set granite stone 20 x 12 x 10 on S.E. side of knoll for 1/4 Sec. Cor. A pine, 48 in. diam. brs. N.8°W., 103 lks. dist.; a fir, 6 ins. diam., brs. S.58°E., 54 lks. dist.


Monument and Accessories found: (condition and source)

At the proportioned point I found a distinct mound of granite stone badly decayed with no stone of record size. The area has been greatly disturbed by logging and fire.

DIAGRAM

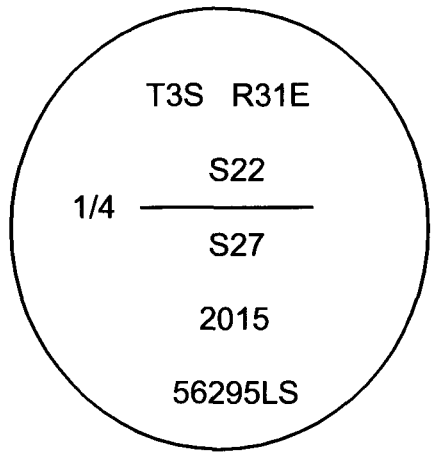

SKETCH

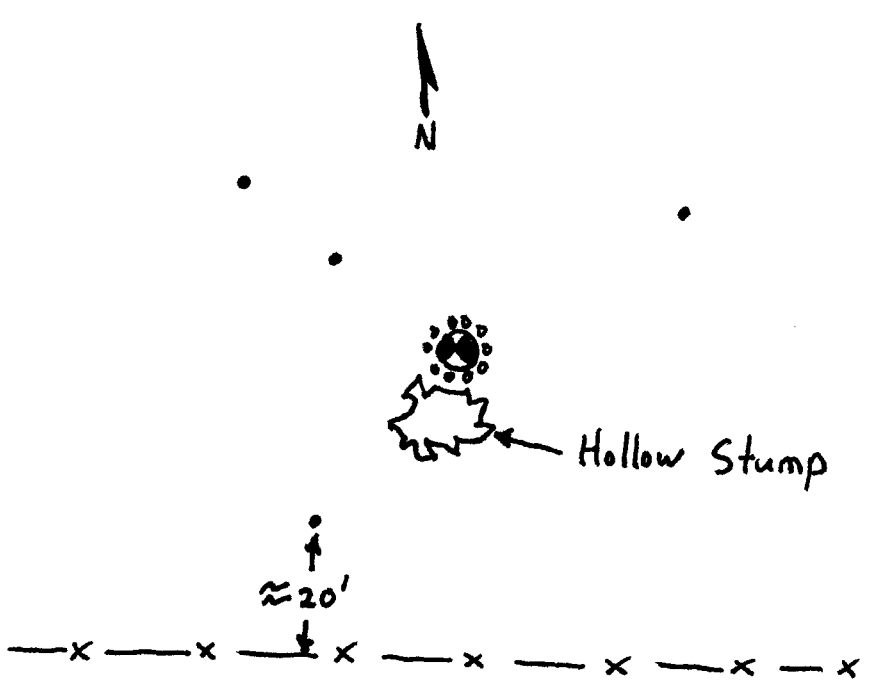

- = Brass Cap in stone mound
- = Rebar Reference
- = Steel guard post with monument sign

MONUMENT (S) AND ACCESSORIES SET (Procedures and Description)

At the proportionate point I set a 2 3/8" brass cap on a 1 1/2" x 30" galvanized iron pipe 30" in the ground. I built a collar of granite stone around the cap approximately 2 feet in diameter.

For references, I set four 5/8" by 24" rebars with 1.25" orange plastic caps stamped WTS and 56295LS as described below:

- an iron rebar bears N39°33'29"W, 32.77 feet;
- an iron rebar bears N40°49'41"W, 15.46 feet;
- an iron rebar bears S49°19'34"W, 19.61 feet;
- an iron rebar bears N59°54'19"E, 35.48 feet;

The monument was set and references tied using a Trimble R7/R8 RTK GPS.

Location and comments
 Witnessed By:

Compass Declination

Surveyors Seal

RECEIVED BY:
 Umatilla County Surveyor
 Date: 07-15
 Rec'd By: *m. [signature]*
 No. 15-062-B

Firm / Agency
 Witness Tree Surveying
 Address
 P.O. Box G
 Pilot Rock, Or. 97868
 Party Chief
 Stephen K, Haddock

REGISTERED
 PROFESSIONAL
 LAND SURVEYOR

Stephen K. Haddock

OREGON
 JULY 9, 2001
 STEPHEN K. HADDOCK
 56295LS

RENEWS: 6-30-17