

OREGON CORNER RESTORATION FORM

Section 27 Township 3S Range 31E
 County Umatilla Date: October 26, 2000

Corner Designation: 3S31R17

Corner to sections 22, 23, 26, and 27, T3S, R31E,
 W.M., Umatilla County, Oregon.

Previous Renewals / Surveys, etc.

Corner originally set by George S. Pershin under contract #319 dated March 26, 1879.
 His record reads: Set granite stone 16 x 10 x 5 on E. mountain side for cor. to secs. 22, 23,
 26 and 27, from which:


- A pine, 22 ins. diam. brs. N74°E, 88 lks. dist.,
- A fir, 8 ins. diam. brs. S44°E, 71 lks. dist.,
- A pine, 20 ins. diam. brs. S22°W, 86 lks. dist.,
- A pine, 30 ins. diam. brs. N48°W, 14 lks. dist.,

Condition Report Only
 Not found
 Remonumented
 Unrecorded
 Surveyed in
 Referenced out


Monument and Accessories found: (condition and source)

The original stone, plainly notched with 4 notches on one edge and 2 notches on another loose on the ground. A down, decayed pine with the pitched, scribed face, among the rotten wood in the location of the NW Bt. A sawed fir stump with the bottom of the BT blaze visible with no scribing left. A sawed pine stump with the scribed face detached and lying at the foot of the stump for the SW Bt.

DIAGRAM

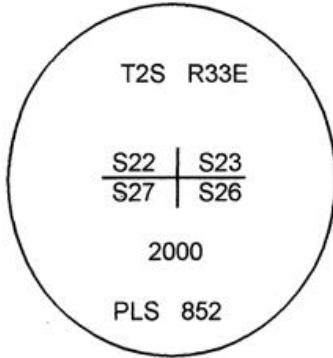

SKETCH

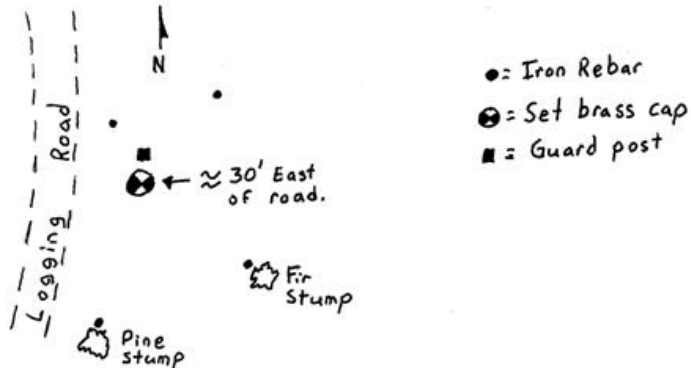

MONUMENT (S) AND ACCESSORIES SET (Procedures and Description)

Set a 1 1/2" x 30" galvanized iron pipe with a 2 1/4" brass cap stamped as shown in the diagram above at record distances from the fir and SW BT stumps. Set a 6' steel post with a county monument sign attached along side. Buried the original stone at the foot of the pipe.

For references, I set four, 5/8" by 24" rebars with 1.25" red plastic caps stamped ORLS 852 and WAL5 13922 as described below:

- an iron rebar bears N63°28'04"W, 11.28 feet;
- an iron rebar bears N13°23'54"E, 26.91 feet;
- an iron rebar bears S14°28'48"W, 56.08 feet at the foot of the SW pine BT stump;
- an iron rebar bears S45°38'31"E, 45.63 feet at the foot of the Fir BT stump;

The monument and references were tied using a LIECA system 300 RTK GPS.

Location and comments

Compass Declination
 Bearings shown ar true.

Surveyors Seal

RECEIVED BY:
 Umatilla County Surveyor
 Date: 11-00
 Rec'd By: KK
 No. 00-281-B
252

Firm / Agency
 Haddock Surveying
 Address
 P.O. Box 1574
 Pendleton, Or. 97801
 Party Chief
 Stephen K, Haddock

REGISTERED
 PROFESSIONAL
 LAND SURVEYOR

David L. Haddock

OREGON
 JULY 12, 1988
 DAVID L. HADDOCK
 852

RENEWS 6-30-01