

Index File No. V-11

CORNER RECORD (SEARCH)

Tract or Survey No. 5-63 Cor. No. V-11


T 3S R. 31E

R.D. Ukiah County Umatilla

Merid. Willamette

N.F. Umatilla State Oregon

CORNER DIAGRAM

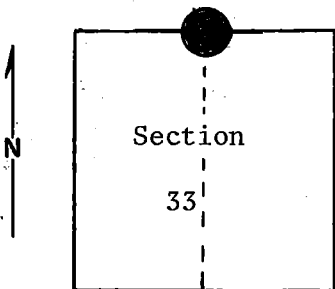

DESCRIBE CORNER MONUMENT FOUND

Material: Basalt stone. Size: 12 x 10 x 6.
Monumented By BLM, 1978
Eight inches above ground; good condition. Appears to have 1/4 scratched on north face.

DESCRIBE BEARING TREES OR OTHER OFFICIAL ACCESSORIES FOUND

A 12-inch l.p.pine bears N68°E, approximately 12 feet. It is scribed 1/4 S, B.T.
A very rotten, down l.p.pine bears S42°E, approximately 20 feet. A sliver (the only sound remainder of the tree) is scribed 1/4 S. (Distances are obviously reversed from GLO notes.)

PHOTO IDENTIFICATION DATA

Photo No. _____
Filed At. _____
Object Ident. _____
Ident. By _____
Signature

DESCRIBE CORNER LOCATION RELATIVE TO NEAR-BY FEATURES, ALSO HOW TO REACH CORNER

Stone sets in north-south fence. A cabin bears approximately NE about 200 feet. A primitive road ends at cabin.

PLANE COORDINATE POSITION DATA

State _____ Zone _____
X _____
Y _____
Estab. By _____
Agency

Signature: T, Hollamon Title: Engineering Technician Division: _____ Headquarters: S, O, Date: November 21, 1974 7100-52 REV. 65 5

CORNER RECORD (PERPETUATION)

MONUMENT : DESCRIBE NEW MONUMENT SET, OR WORK DONE TO PRESERVE EXISTING MONUMENT

9

ACCESSORIES : DESCRIBE NEW BT'S WITNESS OBJECTS ETC. ESTABLISHED, OR WORK DONE TO PRESERVE EXISTING EVIDENCE

Placed blank B.T. tag on the standing B.T. Set an old fence post in the stump hole of the SE B.T., and placed blank B.T. tag on it. Set scribed sliver in hole with post.

10

Work Done By _____ Title _____ Date _____ State Registration No. or Agency _____

Certified Cor. Record Prepared ? Yes No Filed At: _____ Date _____ 11

REMARKS

12

Index File No. T. R. M. Tract or Surv. No. Cor, 13