


Index
File No. V-9

CORNER RECORD (SEARCH)

Tract-or
Survey No. 5-64 Cor.
No. V-9

T 3S R. 31E R.D. Ukiah County Umatilla
Merid. Willamette N.F. Umatilla State Oregon

CORNER DIAGRAM

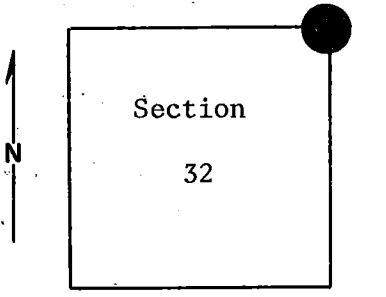

DESCRIBE CORNER MONUMENT FOUND

Material: Granite stone. Size: 16" x 10" x 6".
Monumented by BLM, 1978
Eight inches above ground; good condition. Four notches on SE face.

2

DESCRIBE BEARING TREES OR OTHER OFFICIAL ACCESSORIES FOUND

24" live tamarack bears N58°E, approximately 15 feet in distance. Blaze is closed, but is apparent B.T.
18" tamarack snag bears N48°W, approximately 50 feet. Scribing is 3S, S29, B.T.
No evidence of other 2 B.T.

3

DESCRIBE CORNER LOCATION RELATIVE TO NEAR-BY FEATURES, ALSO HOW TO REACH CORNER

PHOTO IDENTIFICATION DATA

Photo No. _____
Filed At. _____
Object Ident. _____
Ident. By _____
Signature

6

7

PLANE COORDINATE POSITION DATA

State _____ Zone _____
X _____
Y _____
Estab. By _____
Agency

8

4

Signature: B, Moore Title: Engineering Technician Division: _____ Headquarters: S,O, Date: November 1974 7100-52
REV. 65 5

CORNER RECORD (PERPETUATION)

MONUMENT : DESCRIBE NEW MONUMENT SET, OR WORK DONE TO PRESERVE EXISTING MONUMENT

ACCESSORIES : DESCRIBE NEW BT'S WITNESS OBJECTS ETC. ESTABLISHED, OR WORK DONE TO PRESERVE EXISTING EVIDENCE

Put up blank B.T. tags on the 2 B.T.'s.

Work Done By _____ Title _____ Date _____ State Registration No. or Agency _____

Certified Cor. Record Prepared ? Yes No Filed At: _____ Date _____

REMARKS