

USDA-FOREST SERVICE

Index File No. Z-25

CORNER RECORD (SEARCH)


(Ref. FSM 7151.4)

Tract or Survey No. _____ Cor. No. Z-25

T 3S R. 30 1/2 E R.D. UK194 County _____

Merid. _____ N.F. _____ State _____

CORNER DIAGRAM

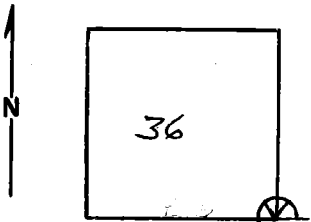

DESCRIBE CORNER MONUMENT FOUND

4 ft. Diameter stone mound. Stone in center is approx. 18" x 8" x 7" and sits on end.

DESCRIBE BEARING TREES OR OTHER OFFICIAL ACCESSORIES FOUND

A 30" Pond. Pine, Very Crooked and dying, bears N 55° W, approx. 75 ft. Scribing visible.

A 30" Pond. Pine, approx. 500 ft. West, beside primitive road, has location posten. I did not have the original notes, other B.T.'s may still be existing.

DESCRIBE CORNER LOCATION RELATIVE TO NEAR-BY FEATURES, ALSO HOW TO REACH CORNER

Mound is approx. 200 ft. East of Summit of ridge.

PHOTO IDENTIFICATION DATA

Photo No. _____
 Filed At. _____
 Object Ident. _____
 Ident. By _____
 Signature _____

PLANE COORDINATE POSITION DATA

State _____ Zone _____
 X _____
 Y _____
 Estab. By _____
 Agency _____

Signature T. Hollann

Title _____ Division _____ Headquarters _____

Date 4-16-80 7100-52-(3/68)

CORNER RECORD (PERPETUATION)

MONUMENT: DESCRIBE NEW MONUMENT SET, OR WORK DONE TO PRESERVE EXISTING MONUMENT

ACCESSORIES : DESCRIBE NEW BT's WITNESS OBJECTS ETC. ESTABLISHED, OR WORK DONE TO PRESERVE EXISTING EVIDENCE

Work Done By _____ **Title** _____ **Date** _____ **State Registration No.**
or Agency _____

Certified Cor. Record Prepared ? Yes No **Filed At:** _____ **Date** _____

REMARKS

Index File No. _____ **T.** _____ **R.** _____ **M.** _____ **Tract or Surv. No.** _____ **Cor.** _____