

Index
File No. Z-17

CORNER RECORD (SEARCH)

(Ref. FSM 7151.4)

Tract or Survey No. Sec 34 Cor. No. SECor 12

T 3S R. 31E R.D. Ukiah County Umatilla
Merid. Willamette N.F. Umatilla State Oregon

CORNER DIAGRAM

T3S R31E
S34 | S35
T4S R31E
S1



DESCRIBE CORNER MONUMENT FOUND

3" brass cap on 2 1/2" I. pipe protruding 3" from ground in mound of stone.

DESCRIBE BEARING TREES OR OTHER OFFICIAL ACCESSORIES FOUND

- A Pine St brs N28°E 20.4 ft dist - (old BT, visible scribing).
- A 12" dia P.St.brs N2°W 26.5 ft dist tagg S2°E 26.51 ft dist-(old BT, visible scribing).
- A 20" dia Pine brs S59°W24.0 ft dist tagg N59°E24.0 ft dist (old BT h.bl.)
- A 15" dia R.Fir brs N66°W49.1ft dist tagg S66°E74 lk dist-recent blaze.
- A 17" dia R.Fir brs N64 1/2°E92.0 ft dist tagg S64 1/2°W140 lk dist-recent bla

DESCRIBE CORNER LOCATION RELATIVE TO NEAR-BY FEATURES, ALSO HOW TO REACH CORNER
Road #5420 to road #5412-100, then West on road #5412-100 approx. 1.4 miles to fork in road going South through gate in fence, then South along road 0.4 mile to corner at West edge of road in small opening on nearly level site.

PHOTO IDENTIFICATION DATA

Photo No. 616140 380-3
Filed At. Umatilla Nat.Forest
Object Ident. Trees
Ident. By _____
Signature

PLANE COORDINATE POSITION DATA

State _____ Zone _____
X _____
Y _____
Estab. By _____
Agency

Signature William R. Wells Title PLS 1106 Division _____ Headquarters _____ Date October 7, 1982 7100-52 (3-68)

CORNER RECORD (PERPETUATION)

MONUMENT: DESCRIBE NEW MONUMENT SET, OR WORK DONE TO PRESERVE EXISTING MONUMENT

Set steel fence post with 54-4 sign attached, North of corner.
 Cap is standard BLM. Cap marked:

T3S	R31E
S34	S35
T4S	R31E
S2	
1978	

ACCESSORIES : DESCRIBE NEW BTLs WITNESS OBJECTS ETC. ESTABLISHED, OR WORK DONE TO PRESERVE EXISTING EVIDENCE

Blaze faces and 6" bands around bearing trees are painted red. Tagged trees with 54-3 & 4 signs where needed.

Work Done By W.R. Wells Title Surveyor Date 10/7/82 State Registration No. PLS 1106
 or Agency

Certified Cor. Record Prepared? Yes No Filed At: Umatilla County Surveyor Office Date _____

REMARKS

Witnessed by: Leslie E. Wilson

Index File No.
Z-17

T. 3S

R. 31E

M. W.M.

Tract or Surv. No.

Sec 34

Cor. SE Cor

Index
File No. Z-17

CORNER RECORD (SEARCH)

Tract or
Survey No. 5-42 Cor. No. Z-17


T 3S R. 31E

R.D. Ukiah County Umatilla

Merid. Willamette

N.F. Umatilla State Oregon

CORNER DIAGRAM

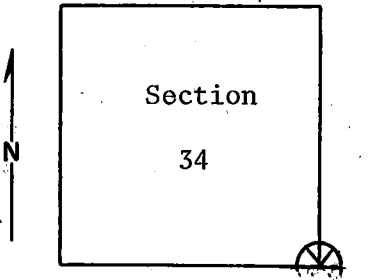

DESCRIBE CORNER MONUMENT FOUND

Material: Stone mound. Size: Mound has 20-inch diameter.
Eight inches above ground; fair condition. No markings visible.

DESCRIBE BEARING TREES OR OTHER OFFICIAL ACCESSORIES FOUND

A 10-inch pine, down and very rotten, bears N28°E, approximately 18 feet. Some scribing visible.

No evidence of SE B.T.

A 17-inch p.pine bears S56°W, approximately 24 feet. Has closed blaze facing stone mound, plus old location poster. Is in proper GLO location.

A 20-inch p.pine stump bears N2°W, (cont. in block 12.)

DESCRIBE CORNER LOCATION RELATIVE TO NEAR-BY FEATURES, ALSO HOW TO REACH CORNER

Corner is about 25 feet west of a primitive road. See Carney Butte 7.5 minute quadrant map.

PHOTO IDENTIFICATION DATA

Photo No. _____

Filed At. _____

Object Ident. _____

Ident. By _____

Signature

PLANE COORDINATE POSITION DATA

State _____ Zone _____

X _____

Y _____

Estab. By _____

Agency

Signature:
T, Hollamon

Title
Engineering Technician

Division
Headquarters
S, O,

Date
November 7, 1974

7100-52
REV. 65 5

CORNER RECORD (PERPETUATION)

MONUMENT : DESCRIBE NEW MONUMENT SET, OR WORK DONE TO PRESERVE EXISTING MONUMENT

ACCESSORIES : DESCRIBE NEW BT's WITNESS OBJECTS ETC. ESTABLISHED, OR WORK DONE TO PRESERVE EXISTING EVIDENCE

I placed blank B.T. tags on the SW B.T. and the NW and NE B.T. remains.

Work Done By _____ Title _____ Date _____ State Registration No. _____
or Agency _____
Certified Cor. Record Prepared ? Yes No Filed At: _____ Date _____

REMARKS

(Block #3, cont.) approximately 27 feet. Very rotten. B.T. scribing barely visible.
Remarks: Corner set in November 1878, assuming it to be common to Sections 34 and 35, T3S, R31E and Sections 2 and 3, T4S, R31E. It is not. It is common to Sections 34 and 35, T3S, R31E only. The B.T. standing in the SW quadrant is not valid for Section 2, but is a good reference to the corner. NE and NW B.T.'s nearly gone. Corner should be monumented soon.

Index File No. T. R. M. Tract or Surv. No. Cor. _____