


Index File No. Z-9

CORNER RECORD (SEARCH)

Tract or Survey No. 5-58 Cor. No. Z-9

T 3S R. 31E R.D. Ukiah County Umatilla  
Merid. Willamette N.F. Umatilla State Oregon

CORNER DIAGRAM

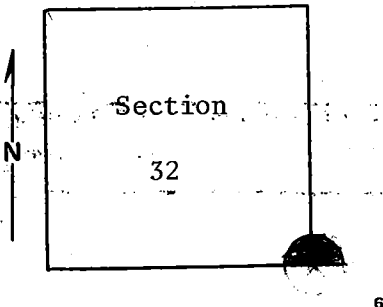

DESCRIBE CORNER MONUMENT FOUND

Material: None.

*Monumented by BLM, 1978*

DESCRIBE BEARING TREES OR OTHER OFFICIAL ACCESSORIES FOUND

30-inch p.pine in SE quadrant. Scribing excellent.  
T4S, R31E, S4, B.T. (Pine is dead and bark is peeling off.)

PHOTO IDENTIFICATION DATA

Photo No. \_\_\_\_\_  
Filed At. \_\_\_\_\_  
Object Ident. \_\_\_\_\_  
Ident. By: \_\_\_\_\_  
*Signature*

DESCRIBE CORNER LOCATION RELATIVE TO NEAR-BY FEATURES, ALSO HOW TO REACH CORNER

PLANE COORDINATE POSITION DATA

State \_\_\_\_\_ Zone \_\_\_\_\_  
X \_\_\_\_\_  
Y \_\_\_\_\_  
Estab. By \_\_\_\_\_  
*Agency*

Signature B. Moore Title Engineering Technician Division \_\_\_\_\_ Headquarters S.O. Date November 1974 7100-52 REV. 65 5

**CORNER RECORD (PERPETUATION)**

**MONUMENT : DESCRIBE NEW MONUMENT SET, OR WORK DONE TO PRESERVE EXISTING MONUMENT**

9

**ACCESSORIES : DESCRIBE NEW BT's WITNESS OBJECTS ETC. ESTABLISHED, OR WORK DONE TO PRESERVE EXISTING EVIDENCE**

I put blank B.T. tag on B.T.

10

**Work Done By** \_\_\_\_\_ **Title** \_\_\_\_\_ **Date** \_\_\_\_\_ **State Registration No. or Agency** \_\_\_\_\_

**Certified Cor. Record Prepared ?** Yes  No  **Filed At:** \_\_\_\_\_ **Date** \_\_\_\_\_ 11

**REMARKS**

12

**Index File No.** T. R. M. **Tract or Surv. No.** **Cor.** 13