

OREGON CORNER RESTORATION FORM

Section 11 Township 3S Range 32E
 County Umatilla Date: October 22nd, 2022

Corner Designation: 3S32E19

Condition report only
 Not Found

Quarter Corner common to Sections 2, and 11, T3S, R32E, W.M., Umatilla County, Oregon.

X Remonumented
 Unrecorded
 Surveyed In
X Referenced Out


Previous Renewals, Surveys, etc...

This corner was originally set by George S. Pershin under GLO contract 430 dated March 23rd, 1882. His record reads: Set a basalt stone 18x10x5 ins. 12 ins. In the ground on N.W. slope for 1/4 sec. cor. marked 1/4 on N. face. A fir 18 ins. diam. brs. N. 40° E. 57 lks. Dist. marked 1/4 S. B.T. A fir 20 ins. diam. brs. S. 53° W. 19 lks. dist. marked 1/4 S. B.T.


Monument and accessories found: (condition and source)

The original NE BT fallen on the clearly scribed blazed face with the tap root still attached in the stump hole. The original SW BT loose on the ground with an unscribed blazed face.

DIAGRAM

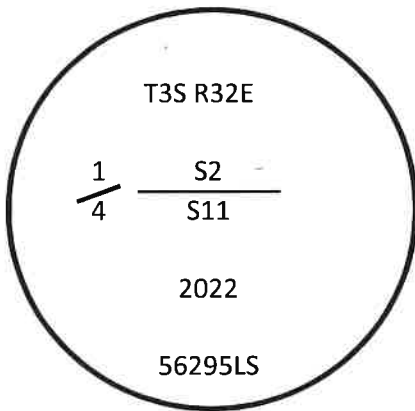

⊗ = Brass Cap
 • = Rebar Reference

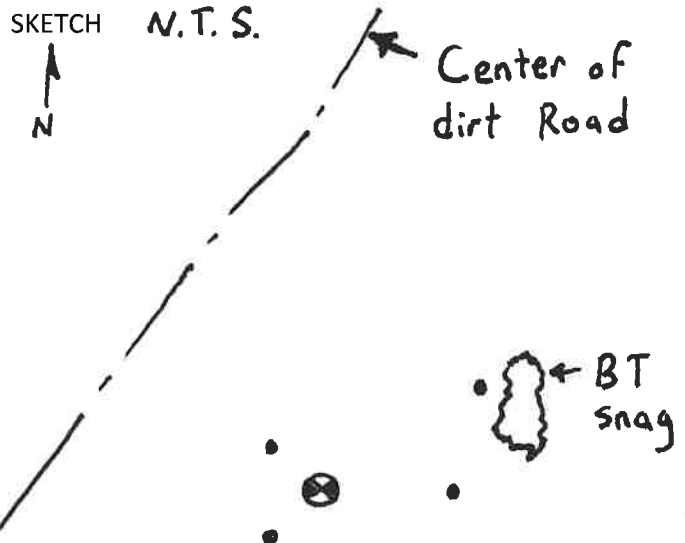

MONUMENT(S) AND ACCESSORIES SET (Procedures and Description)

At the position calculated at record bearing and distance from the found NE BT, I set a 2 3/8" brass cap on a 1 1/2"x30" galvanized iron pipe 26" in the ground. I built a small collar of stone around the cap.

For references I set four 5/8" by 24" iron rebars with 1.25" orange plastic caps stamped WTS and 56295LS as described below:

- An iron rebar bears N40°30'31"E, 35.22 feet flush with the surface near the original BT stump;
- An iron rebar bears S88°36'31"E 28.03 feet flush with the surface;
- An iron rebar bears N46°12'26"W 12.87 feet flush with the surface;
- An iron rebar bears S44°54'22"W 15.91 feet flush with the surface;

The monument was tied using a Trimble R8S RTK GPS Base - Rover pair.

Location and comments:

Compass Declination

Surveyor's Seal

RECEIVED BY: CT
 Umatilla County Surveyor
 Date: 11/21/22
 Rec'd By: 22-131-K

Firm / Agency
 Witness Tree Surveying
 Address
 P.O. Box G
 Pilot Rock, OR 97868
 Party Chief
 Stephen K. Haddock



RENEWS: 6-30-23