


# RECORD OF LAND CORNER MONUMENTATION

WEST 1/4 CORNER SECTION 12, T. 3 S., R. 32 E., W.M.

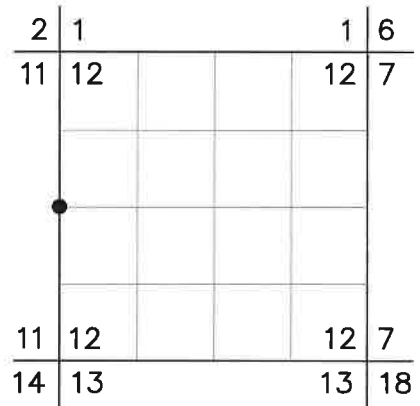

**ORIGINALLY ESTABLISHED BY:** George S. Pershin, U.S. Deputy Surveyor

**CONTRACT NUMBER:** 430

**CONTRACT DATE:** March 23, 1882

**SUBSEQUENT SURVEYS:**

- ▶ 2022 Remonumentation by Stephen K. Haddock, PLS #56295, recorded in the Umatilla County Surveyor's office November 21, 2022, as Survey No. 22-131-B.

**ORIGINAL DESCRIPTION:**

- A Fir 4 ins. di. on N.W. Slope for 1/4 Sec. cor. marked 1/4 on W. side
- A Fir 5 ins. di. brs. N.46°E. 19 lks dist marked 1/4S B.T.
- A Fir 7 ins. di. brs. N.40°W. 18 lks dist marked 1/4S B.T.

**2022 REMONUMENTATION:**

*Monument and accessories found: (condition and source)*  
None. The point was reestablished by single proportion.

*MONUMENT(S) AND ACCESSORIES SET (Procedures and Description)* At the proportionate point I set a 2 3/8" brass cap on a 1 1/2"x30" galvanized iron pipe 28 inches in the ground.

For references I set four 5/8" by 24" rebars with 1.25" orange plastic caps stamped WTS and 56295LS as described below:


- An iron rebar bears N58°06'01"W, 53.24 feet flush with the surface;
- An iron rebar bears S63°57'39"W, 39.81 feet flush with the surface;
- An iron rebar bears S64°04'42"W, 60.92 feet flush with the surface;
- An iron rebar bears S07°41'59"W, 42.18 feet flush with the surface;

**EVIDENCE FOUND:** Found a 1 1/2" galvanized iron pipe with 2 1/2" brass cap (marked as shown below), projecting 4" above ground with no visible mound of stone. I accept the found monument for the position of the corner.

From which, I also found the following **REFERENCE POINTS BY HADDOCK:**

- ▶ A 5/8" iron pin bears S.07°46'W., 42.39 ft. (Record S.07°41'59"W., 42.18 ft.), with attached 1 1/4" diameter orange plastic cap marked "WTS 56295LS"
- ▶ A 5/8" iron pin bears S.63°50'W., 39.86 ft. (Record S.63°57'39"W., 39.81 ft.), with attached 1 1/4" diameter orange plastic cap marked "WTS 56295LS"
- ▶ A 5/8" iron pin bears S.64°07'W., 60.86 ft. (Record S.64°04'42"W., 60.92 ft.), with attached 1 1/4" diameter orange plastic cap marked "WTS 56295LS"
- ▶ A 5/8" iron pin bears N.58°11'W., 53.20 ft. (Record N.58°06'01"W., 53.24 ft.), with attached 1 1/4" diameter orange plastic cap marked "WTS 56295LS"

CORNER MONUMENT MARKED:

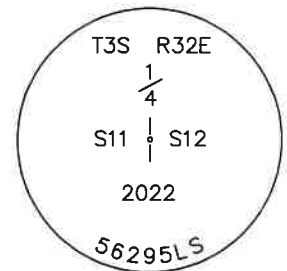

Distances to accessories measured with an EDM. Used RTK GPS to measure bearings. Bearings are geodetic, derived from GPS observation at the corner. Set an aluminum guard post south and alongside, with USFS 54-2 and 54-9 signs attached.

**RESTORATION BY, STAMP AND DATE:**

Work completed June 12, 2024 by:

Jason L. Hatfield, PLS  
Vince L. Kelly, Survey Technician  
Spencer B. Jones, Survey Technician

USDA FOREST SERVICE  
NORTHEAST OREGON LAND ZONE  
1550 Dewey Avenue, Suite A  
Baker City, OR 97814  
(541) 523-1283



EXPIRES: 6/30/2025

24-078-8