

USDA-FOREST SERVICE

Index
File No. J-21

CORNER RECORD (SEARCH)

(Ref. FSM 7151.4)

Tract or
Survey No. _____ Cor.
No. _____


T 3 S R. 32 E

R.D. North Fork John Day County Umatilla

Merid. WILLAMETTE

N.F. Umatilla State OREGON

CORNER DIAGRAM

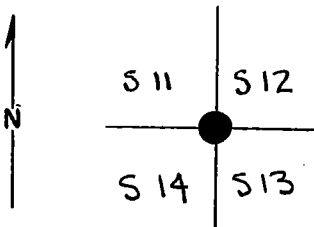

DESCRIBE CORNER MONUMENT FOUND

Several stones of Record size - None with marks visible.

DESCRIBE BEARING TREES OR OTHER OFFICIAL ACCESSORIES FOUND

A Broken and Decayed stump with A Decayed ~~Patula~~ Pine Lying Alongside with scribe "B" visible Bears N77°W 120.8ft

A Root Hole with A Decayed Pond. Pine Lying Alongside with scribes "T3SR32ES" visible Bears S20°E 87.8ft

DESCRIBE CORNER LOCATION RELATIVE TO NEAR-BY FEATURES, ALSO HOW TO REACH CORNER

Corner Point falls in A Fence Jack - A large M.O.S. in Fence corner - fence Projecting N & W.

Follow Fence south from gate on sage flat road.

PHOTO IDENTIFICATION DATA

Photo No. _____
Filed At. _____
Object Ident. _____
Ident. By _____
Signature

PLANE COORDINATE POSITION DATA

State _____ Zone _____
X _____
Y _____
Estab. By _____
Agency

Signature

Wam MScam

Title

Surveying Tech

Division

Headquarters

Date

6/9/87

FS-7100-52 (9/68)

CORNER RECORD (PERPETUATION)

MONUMENT: DESCRIBE NEW MONUMENT SET, OR WORK DONE TO PRESERVE EXISTING MONUMENT

Set A 2 1/2" x 30" ALUM Pipe, 15" into Ground, with 2 1/2" Alum. Cap Marked As Showen. Built A m.o.s. Around and over capped pipe.

T35 R32E
S11 | S12
S14 | S13
LS 1636
1987

9

ACCESSORIES : DESCRIBE NEW BT'S WITNESS OBJECTS ETC. ESTABLISHED, OR WORK DONE TO PRESERVE EXISTING EVIDENCE

A 13" Pond. Pine Bears N 68° W 47.9 ft. scribed "T35 R32E S11 BT" on a single blaze
 A 17" Douglas Fir Bears N 11° E 22.1 ft scribed "T35 R32E S12 BT" on a double blaze
 A 24" Pond. Pine Bears S 36° E 104.6 ft scribed "T35 R32E S13 BT" on a single blaze
 A 16" Pond. Pine Bears S 63° W 92.6 ft scribed "T35 R32E S14 BT" on a single blaze
 Nailed A 3/4" Brass washer, MKD "PLS 1636", Flush to blaze in the "B" on
 Each New BT. Also Has A 54-3 & 54-4 sign nailed to each new BT

10

Work Done By D. Gaylord Title PLS Date 6/9/87 State Registration No. 1636
 or Agency

Certified Cor. Record Prepared? Yes No Filed At: UMATILLA Co. SURVEYOR Date 6-87

11

REMARKS

12

Index File No. J-21 T. 35 R. 32E M. WILL Tract or Surv. No. Cor. 13
 GPO : 1984 O - 439-095

Index File No. J-21

CORNER RECORD (SEARCH)

(Ref. FSM 7151.4)

Tract or Survey No. _____ Cor. No. _____


T 31 S R. 32 E

R.D. Ukiah County Umatilla

Merid. Willamette

N.F. Umatilla State Oregon

CORNER DIAGRAM

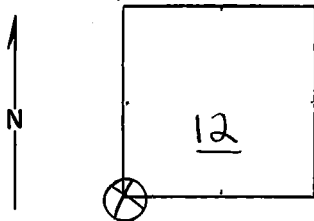

DESCRIBE CORNER MONUMENT FOUND

Material: Fence Corner
 Markings: Fences run north and west only.

DESCRIBE BEARING TREES OR OTHER OFFICIAL ACCESSORIES FOUND

A ponderosa pine, down and rotting, bears approximately S 15° E. approximately 100 feet. Scribing visible. T3S., R.32E., S. 13. It has B.T. tag. A p.pine, down and very rotten bears approx. N 78° W., approximately 100 feet. A sliver on ground under butt is scribed T3S., R.32E., S 11. Tree has a B.T. tag. No other B.T.'s evident. Did not have GLO notes with me for comparison.

PHOTO IDENTIFICATION DATA

Photo No. _____
 Filed At. _____
 Object Ident. _____
 Ident. By _____

Signature

PLANE COORDINATE POSITION DATA

State _____ Zone _____
 X _____
 Y _____
 Estab. By _____

Agency

DESCRIBE CORNER LOCATION RELATIVE TO NEAR-BY FEATURES, ALSO HOW TO REACH CORNER

Follow fence south from gate on Sagebrush Flat road.

Signature
Tom Hollamon

Title
Eng, Tech.

Division

Headquarters

Date
9/17/75

7100-52 (3/68)

6

7

8

2

3

4

5

CORNER RECORD (PERPETUATION)

MONUMENT : DESCRIBE NEW MONUMENT SET, OR WORK DONE TO PRESERVE EXISTING MONUMENT

9

ACCESSORIES : DESCRIBE NEW BT'S WITNESS OBJECTS ETC. ESTABLISHED, OR WORK DONE TO PRESERVE EXISTING EVIDENCE

10

Work Done By _____ Title _____ Date _____ State Registration No. or Agency _____

Certified Cor. Record Prepared ? Yes No Filed At: _____ Date _____

11

REMARKS

12

Index File No. T. R. M. Tract or Surv. No. Cor. _____

13