

Index

CORNER RECORD (SEARCH)

File No.

(Ref.FSM 7151.4)

T 3 S R 32 E

R.D. N. F. John Day County Umatilla

Merid. Willamette

N.F. Umatilla State Oregon

CORNER DIAGRAM

DESCRIBE CORNER MONUMENT FOUND

T3S R32E

Found 20x12x4 stone with 1/4 chiseled in face.

1/4

|

S15-S14

|

PLS 852

1987

DESCRIBE BEARING TREES OR OTHER

OFFICIAL ACCESSORIES FOUND

Stone was in a small stone mound.

PHOTO

IDENTIFICATION

DATA

DESCRIBE CORNER LOCATION RELATIVE TO

Photo No.

NEAR-BY FEATURES, ALSO HOW TO REACH CORNER

Object Ident.

Go south on road 54 from Birch Creek to road 5411. Take road 5411 to road 5411050. Take road 5411050 to road 5411436. Take road 5411436 to road 5411439. Take road 5411439 to third gate. Go south along this fence 2350' to where the fence makes a small eastward jog. The corner is about 50' south of this jog.

Signature

Title

Headquarters

Date

David L. Harlock

Land Surveyor

Pendleton, OR

10-87

CORNER RECORD (PERPETUATION)

MONUMENT : DESCRIBE NEW MONUMENT SET

OR WORK DONE TO PRESERVE EXISTING MONUMENT

Set a 2" I.D. galvanized iron pipe 30" long with 2 1/2" brass cap 18" into the ground and buried the original stone alongside. Stamped the brass cap as shown on the corner diagram. Set a steel fence post 5' north of the monument with Forest Service Land Survey Monument sign attached.

ACCESSORIES: DESCRIBE NEW BT, S WITNESS OBJECTS ETC. ESTABLISHED,

OR WORK DONE TO PRESERVE EXISTING EVIDENCE

Placed a 3' diameter mound of stone around the monument. Scribed 1/4 S15 BT on a 15" Ponderosa Pine which bears N85°30'W, 15.0'. Scribed 1/4 S14 BT on a 10" Ponderosa Pine which bears S1°00'E, 48.7'. The bearings are true. Each scribe is in a 24" blaze. Nailed an aluminum washer, stamped RLS 852 between the letters B and T on each tree. Painted a 6" red band around each tree and attached Forest Service Land Survey Monument and Bearing Tree signs.

Work Done By David L. Haddock Title Land Surveyor Date 10-87

Certified Corner Record Prepared? Yes x No

Filed at Pendleton, OR Date 12-8-87 State Registration No. 852

REMARKS

Index File No. L-17 T. 3 S. R 32 E

M Willamette

USDA-FOREST SERVICE

Index
File No. L-17

CORNER RECORD (SEARCH)

(Ref. FSM 7151.4)

Tract or
Survey No. _____ Cor.
No. _____


T 3S R. 32E

R.D. NORTH FORK County UMATILLA

Merid. WILL

N.F. UMATILLA State OREGON

CORNER DIAGRAM

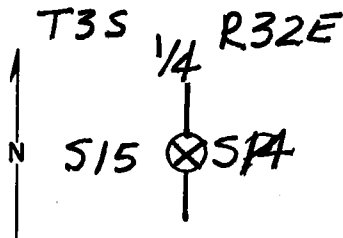

DESCRIBE CORNER MONUMENT FOUND

STONE OF RECORD SIZE PLAINLY MARKED " $\frac{1}{4}$ " LYING IN A SMALL MOUND OF STONES MID-WAY BETWEEN TWO ROCK JACKS OF A VERY OLD FENCE, N-S.

DESCRIBE BEARING TREES OR OTHER OFFICIAL ACCESSORIES FOUND

NONE WERE SET.

PHOTO IDENTIFICATION DATA

Photo No. _____
Filed At. _____
Object Ident. _____
Ident. By _____
* Signature _____

DESCRIBE CORNER LOCATION RELATIVE TO NEAR-BY FEATURES, ALSO HOW TO REACH CORNER

ON EAST EDGE OF LARGE OPEN FLAT, 50 FT WEST OF A NEWER N-S FENCE LINE, I PUT A SIGN ON A 12" PONDEROSA PINE N88°W, 15 FT. FROM CORNER STONE.

PLANE COORDINATE POSITION DATA

State _____ Zone _____
X _____
Y _____
Estab. By _____
Agency _____

Signature

Title

Division

Headquarters

Date

FS-7100-52 (3/68)

Dennis L. Gaylord

LS 1636

S.O.

8-4-87

CORNER RECORD (PERPETUATION)

MONUMENT: DESCRIBE NEW MONUMENT SET, OR WORK DONE TO PRESERVE EXISTING MONUMENT

9

ACCESSORIES : DESCRIBE NEW BT'S WITNESS OBJECTS ETC. ESTABLISHED, OR WORK DONE TO PRESERVE EXISTING EVIDENCE

10

Work Done By _____ Title _____ Date _____ State Registration No.
or Agency _____

Certified Cor. Record Prepared ? Yes No Filed At: _____ Date _____ 11

REMARKS

12

Index File No. T. R. M. Tract or Surv. No. Cor. 13

Index
File No. L-17
T 3 S R. R. 32 E
Merid. Willamette


CORNER RECORD (SEARCH)
(Ref. FSM 7151.4)

R.D. Ukiah County Umatilla
N.F. Umatilla State Oregon

Tract or
Survey No. _____ Cor.
No. _____

L-17

CORNER DIAGRAM

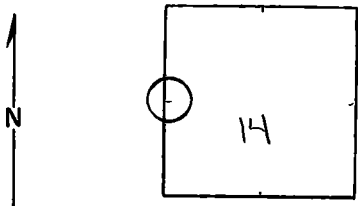

DESCRIBE CORNER MONUMENT FOUND

MATERIAL: None
MARKINGS: North-south fence.

DESCRIBE BEARING TREES OR OTHER OFFICIAL ACCESSORIES FOUND

Many mounds of stone in vicinity (Old Rock Jacks) many stones have been moved. Fence runs erratic in vicinity of where 1/4 corner should be. Will probably have to be re-surveyed.

PHOTO IDENTIFICATION DATA

Photo No. _____
Filed At. _____
Object Ident. _____
Ident. By _____
Signature

DESCRIBE CORNER LOCATION RELATIVE TO NEAR-BY FEATURES, ALSO HOW TO REACH CORNER

PLANE COORDINATE POSITION DATA

State _____ Zone _____
X _____
Y _____
Estab. By _____
Agency

Signature
Tom Hollamon

Title
Eng. Tech.

Division

Headquarters

Date
9/17/75

7100-52 (3/68)

6

7

8

2

3

4

5

CORNER RECORD (PERPETUATION)

MONUMENT: DESCRIBE NEW MONUMENT SET, OR WORK DONE TO PRESERVE EXISTING MONUMENT

9

ACCESSORIES : DESCRIBE NEW BT's WITNESS OBJECTS ETC. ESTABLISHED, OR WORK DONE TO PRESERVE EXISTING EVIDENCE

10

Work Done By _____ Title _____ Date _____ State Registration No. or Agency _____

Certified Cor. Record Prepared ? Yes No Filed At: _____ Date _____

11

REMARKS

12

Index File No. T. R. M. Tract or Surv. No. Cor, 13