


RECORD OF LAND CORNER MONUMENTATION

CENTER 1/4 CORNER SECTION 14, T. 3 S., R. 32 E., W.M.

ORIGINALLY ESTABLISHED BY: CORNER NOT PREVIOUSLY ESTABLISHED

CONTRACT NUMBER: N/A

CONTRACT DATE: N/A

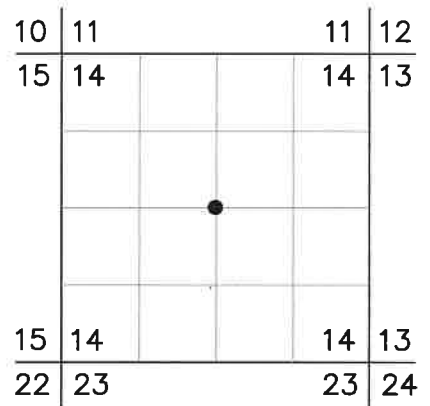

ORIGINAL DESCRIPTION: N/A

EVIDENCE FOUND: N/A


DESCRIPTION OF MONUMENTS AND ACCESSORIES SET AND METHODS USED:

The corner was determined at the intersection of lines connecting opposite corresponding quarter corners. At the corner point, I set a 5/8" x 24" iron pin 14" into a drill hole in bedrock, and attached a 3 1/4" USFS brass cap. Built a 2.5 ft. diameter mound of stone around the monument to top of cap. Cap is marked as shown below.

From which, **I SET NEW REFERENCE POINTS:**

- ▶ A 5/8"x 8" iron pin, driven to bedrock, bears N.44°24'E., 26.71 ft., with attached 2" aluminum cap marked *RP 1 2024 PLS 69454*
- ▶ A 5/8"x 8" iron pin, driven to bedrock, bears S.47°16'E., 42.56 ft., with attached 2" aluminum cap marked *RP 2 2024 PLS 69454*
- ▶ A 5/8"x 8" iron pin, driven to bedrock, bears S.44°58'W., 38.86 ft., with attached 2" aluminum cap marked *RP 3 2024 PLS 69454*
- ▶ A 5/8"x 8" iron pin, driven to bedrock, bears N.61°44'W., 41.24 ft., with attached 2" aluminum cap marked *RP 4 2024 PLS 69454*

CORNER MONUMENT MARKED:

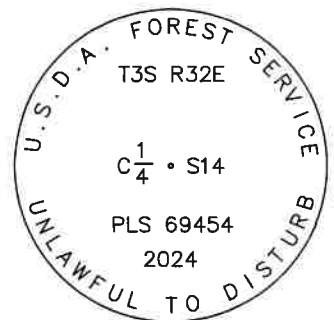

Used RTK GPS to measure reference points. Bearings are geodetic, derived by GPS observation at the corner. Set an aluminum guard post north, 13.5 ft. in a north-south running fence line, with USFS 54-2 and 54-9 signs attached, and another west, 7 ft. in an east-west running fence line, with USFS 54-2 sign attached. Corner is located 1.5 ft. south of a wooden fence corner post, with fences running north and west.

RESTORATION BY, STAMP AND DATE:

Work completed June 26, 2024 by:

Jason L. Hatfield, PLS
 Vince L. Kelly, Survey Technician
 Spencer B. Jones, Survey Technician

USDA FOREST SERVICE
 NORTHEAST OREGON LAND ZONE
 1550 Dewey Avenue, Suite A
 Baker City, OR 97814
 (541) 523-1283



EXPIRES: 6/30/2025