


Index
 File No. P-1
 T 3 S. R. 33 E
 Merid. _____

CORNER RECORD (SEARCH)
 (Ref. FSM 7151.4)
 R.D. UKIAH County UMATILLA
 N.F. UMATILLA State OREGON

Tract or
 Survey No. _____
 Cor.
 No. _____

CORNER DIAGRAM

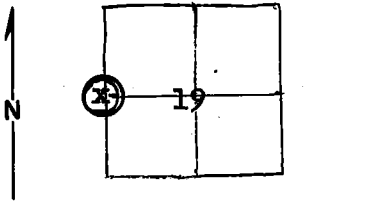

DESCRIBE CORNER MONUMENT FOUND
 Stone 10" x 8" x 8", 8" above ground, marked $\frac{1}{4}$ and in good condition.

DESCRIBE BEARING TREES OR OTHER OFFICIAL ACCESSORIES FOUND
 Both BT's are down and rotting
 (Over)

PHOTO IDENTIFICATION DATA
 Photo No. _____
 Filed At. _____
 Object Ident. _____
 Ident. By _____
Signature

DESCRIBE CORNER LOCATION RELATIVE TO NEAR-BY FEATURES, ALSO HOW TO REACH CORNER

PLANE COORDINATE POSITION DATA
 State _____ Zone _____
 X _____
 Y _____
 Estab. By _____
Agency

Signature	Title	Division	Headquarters	Date	7100-52-(3/68)
Gary Collier			Ukiah	6-8-73	


HL/878 OS

CORNER RECORD (PERPETUATION)

MONUMENT: DESCRIBE NEW MONUMENT SET, OR WORK DONE TO PRESERVE EXISTING MONUMENT

ACCESSORIES: DESCRIBE NEW BT'S WITNESS OBJECTS ETC. ESTABLISHED, OR WORK DONE TO PRESERVE EXISTING EVIDENCE

Tagged new BT's
6" DBH Doug fir brs. N. 51° E. 33 ft.
18" DBH Doug fir brs. N. 39° W. 71 ft.

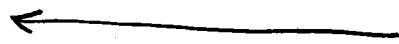

What new B.T.'s? If Non-Professional People (unlicensed) are establishing new B.T.'s they are not legal and serve only to Confuse later reestablishment.

Work Done By _____ Title _____ Date _____ State Registration No. or Agency J&H. 3/75

Certified Cor. Record Prepared? Yes No Filed At: _____ Date _____

REMARKS