

USDA-FOREST SERVICE

Index

File No. T-21

CORNER RECORD (SEARCH)

(Ref. FSM 7151.4)

Tract or

Survey No. Sec 26 Cor. No. E 1/4

T 3S R. 32E

R.D. Ukiah County Umatilla

Merid. Willamette

N.F. Umatilla State Oregon

CORNER DIAGRAM

T3S R32E

1/4

S26 | S25



DESCRIBE CORNER MONUMENT FOUND

Found 12" x 12" x 6" basalt stone marked 1/4 on N E Slope.

DESCRIBE BEARING TREES OR OTHER OFFICIAL ACCESSORIES FOUND

29" Pine bears S67° W 115 lk (old BT) healed blaze.

PHOTO IDENTIFICATION DATA

Photo No. 616140 680-287

Filed At. \_\_\_\_\_

Object Ident. \_\_\_\_\_

Ident. By \_\_\_\_\_

*Signature*

PLANE COORDINATE POSITION DATA

State \_\_\_\_\_ Zone \_\_\_\_\_

X \_\_\_\_\_

Y \_\_\_\_\_

Estab. By \_\_\_\_\_

*Agency*

*Signature*  
William R. Wells

*Title*  
PLS 1106

*Division*

*Headquarters*

*Date*  
September 22, 1982

7100-52 (3/68)

**CORNER RECORD (PERPETUATION)**

**MONUMENT: DESCRIBE NEW MONUMENT SET, OR WORK DONE TO PRESERVE EXISTING MONUMENT**

Set a 2 1/2" x 30" I. pipe w/2 1/2" B. cap 21" in ground and surrounded with mound of stone. Buried original stone alongside, (pipe bent slightly to East due to root).  
 Cap marked:

T3S R32E  
 1/4  
 S26 S25  
 1982  
 PLS 1106

**ACCESSORIES: DESCRIBE NEW BT'S WITNESS OBJECTS ETC. ESTABLISHED, OR WORK DONE TO PRESERVE EXISTING EVIDENCE**

A 20" Red Fir bears S45°E 3.8 ft. marked 1/4 S25 BT.  
 Set steel fence post w/54-4 sign attached on section line near corner.  
 Painted the blaze faces and 6" bands around the bearing trees red. Tagged trees w/54-3 & 4 signs, where needed. New BT has lower blaze, scribed BT, with brass washer stamped PLS 1106 nailed flush.

Work Done By W. R. Wells Title Surveyor Date 9/22/82 State Registration No. PLS 1106  
 or Agency

Certified Cor. Record Prepared? Yes  No  Filed At Umatilla County Surveyor Office Date

**REMARKS**

Witnessed by: D. L. Kaufman PLS

USDA-FOREST SERVICE

Index File No. T-21

**CORNER RECORD (SEARCH)**

(Ref. FSM 7151.4)

Tract or Survey No. \_\_\_\_\_ Cor. No. T-21


T 3S R. 32E

R.D. Ukiah County Umatilla

Merid. Willamette

N.F. Umatilla State Oregon

**CORNER DIAGRAM**

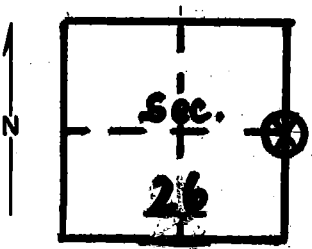

**DESCRIBE CORNER MONUMENT FOUND** (possible)

Material: Basalt stone                      Size: 9 x 9 x 5  
Height Above Ground: 5"  
Markings: None legible.

**DESCRIBE BEARING TREES OR OTHER OFFICIAL ACCESSORIES FOUND**

FS location poster on 20" fir, 3' southeast of stone. 29" dia.  
P. Pine - S69°W - 76' dist. Possible closed blaze east face with  
FS bearing tree poster and att. poster. Tree is on east shoulder of  
road S-20. Sec. board marker on road states 1/4 cor. is 60' north  
which would place it between poss. B.T. (29" pine) and stone.

**PHOTO IDENTIFICATION DATA**

Photo No. \_\_\_\_\_  
Filed At. \_\_\_\_\_  
Object Ident. \_\_\_\_\_  
Ident. By \_\_\_\_\_  
*Signature*

**DESCRIBE CORNER LOCATION RELATIVE TO NEAR-BY FEATURES, ALSO HOW TO REACH CORNER**

**PLANE COORDINATE POSITION DATA**

State \_\_\_\_\_ Zone \_\_\_\_\_  
X \_\_\_\_\_  
Y \_\_\_\_\_  
Estab. By \_\_\_\_\_  
*Agency*

Signature  
**Bill Moore**

Title  
**Eng. Tech.**

Division \_\_\_\_\_

Headquarters \_\_\_\_\_

Date  
**5/77**

7100-52-(3/68)

CORNER RECORD (PERPETUATION)

GPO 902-673

MONUMENT : DESCRIBE NEW MONUMENT SET, OR WORK DONE TO PRESERVE EXISTING MONUMENT

9

ACCESSORIES : DESCRIBE NEW BT's WITNESS OBJECTS ETC. ESTABLISHED, OR WORK DONE TO PRESERVE EXISTING EVIDENCE

10

Work Done By \_\_\_\_\_ Title \_\_\_\_\_ Date \_\_\_\_\_ State Registration No. or Agency \_\_\_\_\_

Certified Cor. Record Prepared ? Yes No Filed At: \_\_\_\_\_ Date \_\_\_\_\_

11

REMARKS

12

Index File No. T. R. M. Tract or Surv. No. Cor. \_\_\_\_\_

13