


(PA)

Index
File No. 7-7CORNER RECORD (SEARCH)
(Ref. FSM 7151.4)Tract or
Survey No. _____ Cor.
No. 7-7T 3S R. 32ER.D. Ukiah County UmatillaMerid. WillametteN.F. Umatilla State Oregon

CORNER DIAGRAM

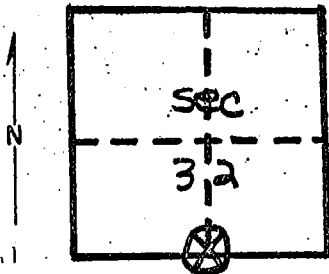

DESCRIBE CORNER MONUMENT FOUND

No Corner was found.

DESCRIBE BEARING TREES OR OTHER OFFICIAL ACCESSORIES FOUND

16" Ponderosa Pine good vigor.
22" Ponderosa Pine

PHOTO IDENTIFICATION DATA

Photo No. _____

Filed At. _____

Object Ident. _____

Ident. By _____

Signature

PLANE COORDINATE POSITION DATA

State _____ Zone _____

X _____

Y _____

Estab. By _____

*Agency**Signature**Title**Division**Headquarters**Date*

7100-52-(3/68)

D. McCullough

FOR. TECH.

USFS

UKIAH

10/3/68