

V-9  
Index File No. \_\_\_\_\_


CORNER RECORD (SEARCH)

Tract or Survey No. \_\_\_\_\_  
Cor. No. V-9

24 16

T 3S R. 33E R.D. Ukiah County Umatilla  
Merid. Willamette N.F. Umatilla State Oregon

CORNER DIAGRAM

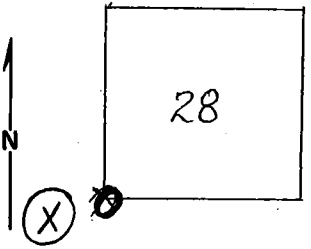

~~DESCRIBE CORNER MONUMENT FOUND~~ *Original notes*

DESCRIBE BEARING TREES OR OTHER OFFICIAL ACCESSORIES FOUND 2

Corner consists of stake 18" above ground  
Larch 10" dia. S57 $\frac{1}{2}$ W  
Metal location poster is on a B. pine  
4" dia. on the E & W line N. of corner bears N84E  
Corner is in dense second growth of Black Pine about 75 yds. E of drift fence

6  
PHOTO IDENTIFICATION DATA  
Photo No. \_\_\_\_\_  
Filed At. \_\_\_\_\_  
Object Ident. \_\_\_\_\_  
Ident. By \_\_\_\_\_  
*Signature* 7

DESCRIBE CORNER LOCATION RELATIVE TO NEAR-BY FEATURES, ALSO HOW TO REACH CORNER 3

PLANE COORDINATE POSITION DATA  
State \_\_\_\_\_ Zone \_\_\_\_\_  
X \_\_\_\_\_  
Y \_\_\_\_\_  
Estab. By \_\_\_\_\_  
*Agency* 8

4

Signature 15/ Geo. B. Clisby Title FR Division \_\_\_\_\_ Headquarters \_\_\_\_\_ Date 9-28-22 7100-52  
REV. 65 5

CORNER RECORD (PERPETUATION)

MONUMENT: DESCRIBE NEW MONUMENT SET, OR WORK DONE TO PRESERVE EXISTING MONUMENT

ACCESSORIES DESCRIBE NEW BT'S WITNESS OBJECTS ETC. ESTABLISHED, OR WORK DONE TO PRESERVE EXISTING EVIDENCE

Work Done By \_\_\_\_\_ Title \_\_\_\_\_ Date \_\_\_\_\_ State Registration No. or Agency \_\_\_\_\_

Certified Cor. Record Prepared ? Yes No Filed At: \_\_\_\_\_ Date \_\_\_\_\_

REMARKS

Index File No. V-9 T. R. M. Tract or Surv. No. Cor. \_\_\_\_\_