

CORNER RESTORATION FORM

Township 4N Range 28E Section 13 County UMATILLA

State OREGON Date 12/19/2013 Number L-23

Corner Designation : C1/4 SECTION 13


- Condition Report Only
- Not Found
- Renewed
- Surveyed In
- Referenced

Previous Renewals _____

Monument (s) Found: (Condition and Source)
FOUND 1/2"X18" IRON REBAR 0.3' BELOW GRADE IN GRASSY
AREA ALONG HERMISTON AIRPORT RUNWAY IN GOOD
CONDITION BUT SLIGHTLY LOSE IN THE GORUND.

MONUMENT DETAIL

Found Set

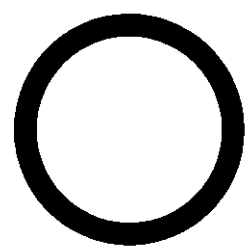


1/2" IRON REBAR

Monuments & Accessories Set:
NONE

Accessories found _____

- ALL BEARINGS SHOWN HERE ARE BASED ON SURVEY FOR HERMISTON MUNICIPAL DATED DECEMBER 2013.
- FND. BRASS CAP MARKING END OF RUNWAY S67°16'16"W 2177.78 FEET FROM C1/4.
 - FND. BRASS CAP MARKING END OF RUNWAY N56°04'53"E 2343.94 FEET FROM C1/4.
 - FND. BRASS CAP MARKING NGS STATION "P520" S28°53'10"E 60.89 FEET FROM C1/4.
 - FND. 5/8" REBAR IN FENCE CORNER N89°33'23"E 567.55 FEET FROM C1/4.
 - FND. 5/8" REBAR IN FENCE CORNER S00°59'39"E 301.44 FEET FROM C1/4.

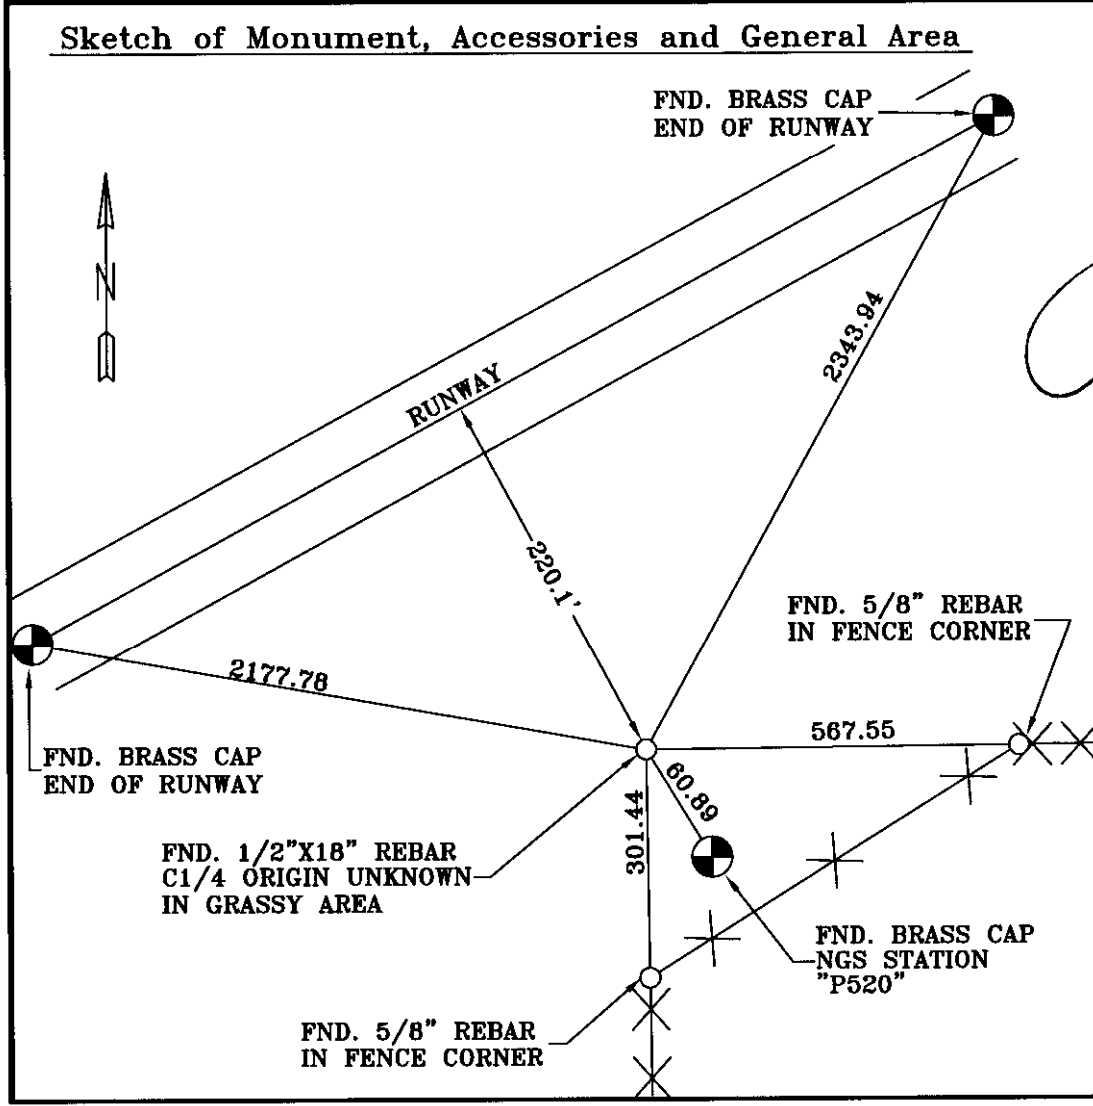

Surveyor's Seal

REGISTERED PROFESSIONAL LAND SURVEYOR

Lance Clarkking

OREGON
MAY 10, 2011
LANCE CLARKKING
61420

RENEWS: 6/30/2015

Agency:
 CK3, LLC
 945 W. ORCHARD
 HERMISTON OREGON 97838
 OFFICE: 541-567-2345
 FAX: 541-567-2305
 WEB: CK3LLC.NET
 Field Book # 0-288

COUNTY SURVEYOR RECORDING INFO

Received 12/31/13

Filed 12/31/13

Survey No. 13-566-B

Drawing No. _____

Index No. _____