

# OREGON CORNER RESTORATION FORM

SECTION 16,17,20,21 TOWNSHIP 4 NORTH RANGE 28 EAST N-9  
 COUNTY : UMATILLA DATE AUG/21

CORNER DESIGNATION  
 SECTION CORNER

- CONDITION REPORT ONLY
- NOT FOUND
- RENEWED
- UNCOVERED
- SURVEYED IN
- REFERENCED

PREVIOUS RENEWALS / SURVEYS, ETC.



SURVEYED IN 1860 BY HAFT. LS 951 RESET THIS MONUMENT IN 1991, HE HELD THE EASTING OF A 1 1/2 INCH IRON PIPE AND THE NORTHING AT THE CENTERLINE OF MINNEHAHA ROAD AS IT WAS SURVEYED BY KIMBRELL IN 1907. SEE OREGON CORNER RESTORATION FORM N-9 IN 1991 BY LS 951.

MONUMENTS AND ACCESSORIES FOUND: CONDITION AND SOURCE

I RECOVERED THE CORNER AND COMPARED ITS LOCATION WITH DUAL MONUMENTATION IN THE AREA AS REQUESTED. PLEASE REFER TO TO RECORD OF SURVEY THAT WAS RECORDED ALONG WITH THIS CORNER RESTORATION FORM FOR MY ANALYSES. THE ACCESSORIES FOR THE CORNER WERE NOT RECOVERED DURING THIS SURVEY DUE TO THE FACT IT HAD NO BEARING ON THE CORNERS LOCATION. PLEASE REFER TO SURVEY NUMBER 19-080-C AND THE CORNER RESTORATION FORMS RECORDED WITH SAID RECORD OF SURVEY FOR ACCESSORY INFORMATION.

MONUMENT DETAIL

SKETCH

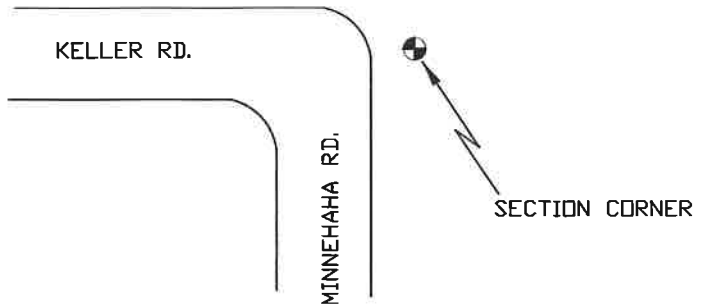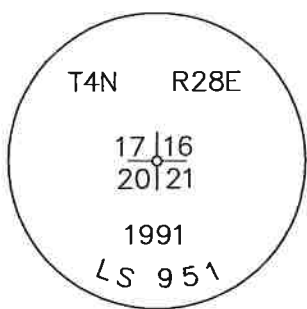

NAD 83/91  
 OREGON STATE PLANE  
 INTERNATIONAL FEET

787533.32  
 8499920.20

MONUMENT SET ( PROCEDURES AND DESCRIPTION )

NEW ACCESSORIES FROM WHICH

LOCATION AND COMMENTS

THE CORNER IS AT THE INTERSECTIONS OF KELLER ROAD AND MINNEHAHA ROAD.

FIRM/AGENCY

PRIMM LAND SURVEYING, INC.  
 P.O. BOX 1322  
 HERMISTON, OREGON 97838

LAND SURVEYOR

BRIT L. PRIMM

WITNESS

KEITH P. PRIMM

SURVEYOR'S SEAL

REGISTERED  
 PROFESSIONAL  
 LAND SURVEYOR

OREGON  
 JULY 13, 1999  
 BRIT L. PRIMM  
 48509

EXPIRATION DATE: 12/31/22