

OREGON CORNER RESTORATION FORM

SECTION 23 TOWNSHIP 4 NORTH RANGE 29 EAST N-17
COUNTY : UMATILLA DATE 8-98

CORNER DESIGNATION

NW CORNER

CONDITION REPORT ONLY
 NOT FOUND
 RENEWED
 UNCOVERED
 SURVEYED IN
 REFERENCED

PREVIOUS RENEWALS / SURVEYS, ETC.


ORIGINALLY SURVEYED IN 1861 BY DAVENPORT UNDER CONTRACT #101. HE SET A POST IN A MOUND OF EARTH AND A CHARRED STAKE..

MONUMENTS AND ACCESSORIES FOUND: CONDITION AND SOURCE

1 1/4" X 70" IRON PIPE 12" ABOVE THE SURFACE AT A CHAIN LINK FENCE CORNER. LAND OWNER IN SECTION 23 SAID HE BUILT FENCE IN SAME LOCATION AS OLD FENCE.

SKETCH

MONUMENT DETAIL

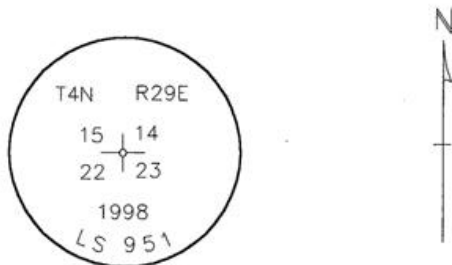

MONUMENT SET (PROCEDURES AND DESCRIPTION)

I PULED IRON PIPE AND REPLACED IT WITH A 1" X 30" IRON PIPE WITH BRASS CAP STAMPED AS ABOVE. I LEFT THE 1 1/4" IRON PIPE LYING ON THE GROUND.

NEW ACCESSORIES FROM WHICH

A 5/8" X 30" IRON REBAR WITH PLASTIC CAP #951 LIES N 89°.06'37" W, 24.50 FEET.
THE BASE OF A 2 1/2" IRON PIPE FENCE CORNER LIES S 23°.00'00" E, 1.00 FEET.
THE BASE OF A 2 1/2" IRON PIPE FENCE POST LIES S 1°.48'00" E, 7.30 FEET.
A 5/8" X 30" IRON REBAR WITH PLASTIC CAP #951 LIES N 0°.17'31" E, 17.17 FEET.

LOCATION AND COMMENTS

COMPASS DEC.

SURVEYOR'S SEAL

FIRM/AGENCY
EDWARDS SURVEYING
P.O. BOX 763
HERMISTON, OREGON 97838
97838

PARTY CHIEF
D. EDWARDS

NOTES

WITNESS
RICK SMITH

RECEIVED BY

Umatilla County Surveyor

Date 10-98

Rec'd By JK

No. 98-213-C

REGISTERED
PROFESSIONAL
LAND SURVEYOR

G. Dennis Edwards

OREGON
JULY 16, 1971
G. DENNIS EDWARDS
951

RENEWS 12/31/99