

CORNER RESTORATION FORM

Township 4N Range 29E Section 13,14,23,24 County UMATILLA

State OREGON Date 3/30/2023 Number N-21 Condition Report Only

Corner Designation : SECTION CORNER: 13, 14, 23, 24 Not Found


Previous Renewals ORIGINAL SOURCE OF CORNER

ORIGINALLY SURVEYED IN 1861 BY DAVENPORT UNDER
 CONTRACT #101, HE SET A STAKE IN MOUND OF EARTH
 1998 EDWARDS SET A 2 3/8" BRASS CAP COUNTY SURVEY NO.
 98-213-C

Renewed
 Surveyed In
 Referenced

MONUMENT DETAIL

Found Set

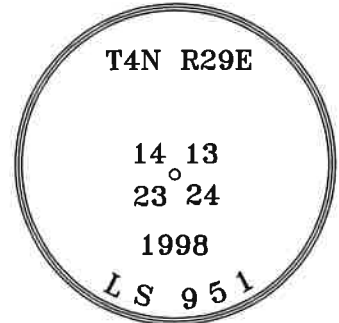

BASIS OF BEARINGS, NAD 83/91 OREGON STATE PLANE
 COORDINATES NORTH ZONE:

NORTHING: 788271.38
 EASTING: 8548108.76

Monument & Accessories Set/Found (Procedure and Description)

AT CORNER FOUND A 2 3/8" BRASS CAP & UMATILLA MON. SIGN, COUNTY SURVEY NO. 98-213-C

FOUND A 5/8" I.R. W/PLASTIC CAP 951 S 33°40' W 244.61', CORNER FORM NO. N21-13-532-C

FOUND A 5/8" I.R. W/PLASTIC CAP 951 N 43°21' W 162.75', CORNER FORM NO. N21-13-532-C

FOUND A 5/8" I.R. W/PLASTIC CAP 951 S 21°10' W 22.88', CORNER FORM NO. N21-13-532-C

FOUND A 5/8" I.R. W/PLASTIC CAP 951 S 62°48' E 152.23', CORNER FORM NO. N21-13-532-C

FOUND A 5/8" I.R. W/PLASTIC CAP 951 S 89°11' W 13.50', CORNER FORM NO. N21-98-213-C

<p><u>Sketch of Monument, Accessories and General Area</u></p>	<div style="border: 1px solid black; padding: 5px; text-align: center;"> <p>REGISTERED PROFESSIONAL LAND SURVEYOR</p> <p><i>[Signature]</i></p> <p>OREGON MAY 10, 2011 LANCE CLARK KING 61420</p> </div> <p style="text-align: center;">RENEWS: 6/30/2023</p> <p>Agency: CK3, LLC 945 W. ORCHARD HERMISTON OREGON 97838 OFFICE: 541-567-2345 FAX: 541-567-2305 WEB: CK3LLC.NET Field Book# 0-350</p> <div style="border: 1px solid black; padding: 5px; text-align: center;"> <p>COUNTY SURVEYOR RECORDING INFO</p> <p>Received <u>CT</u></p> <p>Filed <u>5/4/23</u></p> <p>Survey No. <u>23-042-C</u></p> <p>Drawing No. _____</p> <p>Index No. <u>N-21</u></p> </div>
--	--