

CORNER RESTORATION FORM

Township 4N Range 29E Section 16,17,20,21 County UMATILLA

State OREGON Date 3/30/2023 Number N-9

- Condition Report Only
- Not Found
- Renewed
- Surveyed In
- Referenced


Corner Designation : SECTION CORNER: 16, 17, 20, 21

Previous Renewals ORIGINAL SOURCE OF CORNER

ORIGINALLY SURVEYED IN 1861 BY DAVENPORT UNDER
 CONTRACT #101, HE SET A STAKE IN MOUND OF EARTH
 1885 ZAHNER BUILT MOUND OLD PRIVATE SURVEY 7C
 1995 EDWARDS SET A 2 3/8" BRASS CAP COUNTY SURVEY NO.
 95-059-B

MONUMENT DETAIL

Found Set

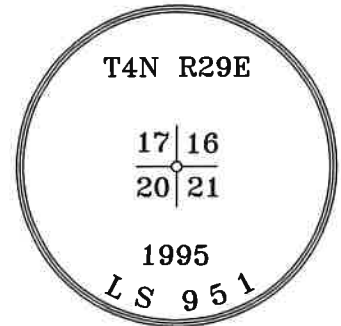


BASIS OF BEARINGS, NAD 83/91 OREGON STATE PLANE
 COORDINATES NORTH ZONE:

NORTHING: 787866.50
 EASTING: 8532255.40

Monument & Accessories Set/Found (Procedure and Description)

- AT CORNER FOUND A 2 3/8" BRASS CAP 7" BELOW GRADE IN EDGE OF FIELD, COUNTY SURVEY NO. 95-059-B
- FOUND A 1 1/4" REBAR 1" BELOW GRADE S 00°48' E 4.71', CORNER FORM NO. N9-95-59-B
- FOUND A 5/8" I.R. N 88°05' E 133.98', CORNER FORM NO. N9-95-59-B
- FOUND A 5/8" I.R. W/YPC "PLS LS 48490" & SET UMATILLA MON. SIGN ON RXR TIE POST N 81°23' E 83.28',
 COUNTY SURVEY NO. CORNER FORM N9-21-004-C
- FOUND A 5/8" I.R. W/YPC "PLS LS 48490" N 49°20' E 129.49', CORNER FORM NO. N9-21-004-C

Sketch of Monument, Accessories and General Area

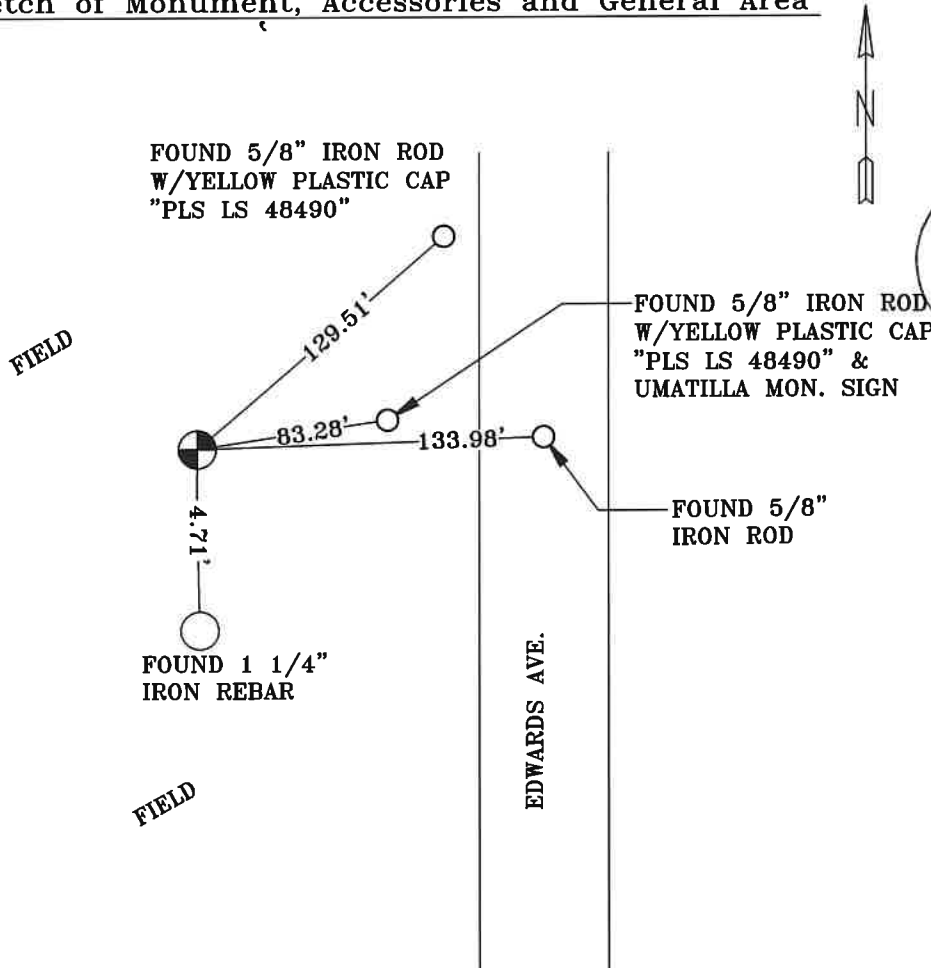

**REGISTERED
 PROFESSIONAL
 LAND SURVEYOR**

Lance Clark King

**OREGON
 MAY 10, 2011
 LANCE CLARK KING
 61420**

RENEWS: 6/30/2023

Agency:
 CK3, LLC
 945 W. ORCHARD
 HERMISTON OREGON 97838
 OFFICE: 541-567-2345
 FAX: 541-567-2305
 WEB: CK3LLC.NET
 Field Book # 0-350

**COUNTY SURVEYOR
 RECORDING INFO**

Received CT

Filed 5/4/23

Survey No. 23-042-C

Drawing No. _____

Index No. N-9