

CORNER RESTORATION FORM

Township 4N Range 29E Section 24, 25 County UMATILLA

State OREGON Date 3/30/2023 Number R-23

Corner Designation : 1/4 CORNER: 24, 25

Condition Report Only

Not Found

Renewed

Surveyed In

Referenced

Previous Renewals ORIGINAL SOURCE OF CORNER

ORIGINALLY SURVEYED IN 1861 BY DAVENPORT UNDER

CONTRACT #101, HE SET A STAKE IN MOUND OF EARTH

1998 EDWARDS SET A 1"X30" I.P. W/ 2-3/8" BRASS CAP BY

MONUMENT DETAIL

Found Set


SINGLE PROPORTION COUNTY SURVEY NO. 98-213-C &

CORNER FORM NO. R23-98-213-C

BASIS OF BEARINGS, NAD 83/91 OREGON STATE PLANE
COORDINATES NORTH ZONE:

NORTHING: 783036.12

EASTING: 8550823.46

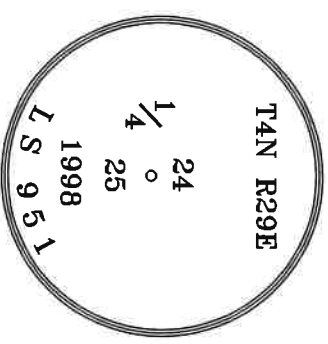

Monument & Accessories Set/Found (Procedure and Description)

AT CORNER FOUND A 2 3/8" BRASS CAP 4" BELOW GRADE & UMATILLA MON. SIGN, COUNTY SURVEY NO.

98-213-C & CORNER FORM NO. R23-98-213-C


FOUND A ALUMINUM TAG 951 ON POWER POLE S 89°06' W 258.53, CORNER FORM NO. R23-98-213-C

FOUND A ALUMINUM TAG 951 ON POWER POLE S 81°48' E 10.77', CORNER FORM NO. R23-98-213-C

FOUND A ALUMINUM TAG 951 ON POWER POLE S 40°19' W 81.29', CORNER FORM NO. R23-98-213-C

FOUND A 5/8" IRON ROD W/PLASTIC CAP #951 S 00°44' W 61.62', CORNER FORM NO. R23-98-213-C

Sketch of Monument, Accessories and General Area

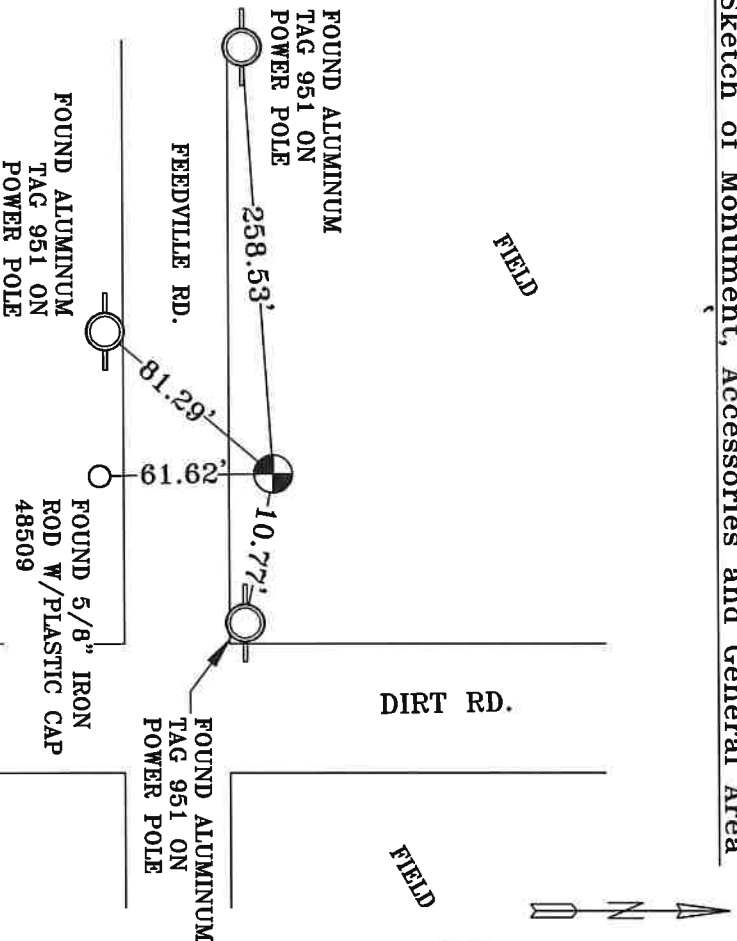

**REGISTERED
PROFESSIONAL
LAND SURVEYOR**

Lance Clark King
**OREGON
MAY 10, 2011
LANCE CLARK KING
61420**

RENEWALS: 6/30/2023

Agency:

CK3, LLC
945 W. ORCHARD
HERMISTON OREGON 97838
OFFICE: 541-567-2345
FAX: 541-567-2305
WEB: CK3LLC.NET
Field Book# 0-350

COUNTY SURVEYOR
RECORDING INFO

Received CT

Filed 5/4/23

Survey No. 23-042-C

Drawing No. _____

Index No. R-23