

CORNER RESTORATION FORM

Township 4N Range 29E Section 27, 28 County UMATILLA

State OREGON Date 3/30/2023 Number T-13

Corner Designation : 1/4 CORNER: 27, 28

Condition Report Only

Not Found
 Renewed

Surveyed In
 Referenced

Previous Renewals ORIGINAL SOURCE OF CORNER

ORIGINALLY SURVEYED IN 1861 BY DAVENPORT UNDER

CONTRACT #101, HE SET A STAKE IN MOUND OF EARTH

1995 EDWARDS SET A 1"X30" I.P. W/ 2-3/8" BRASS CAP BY

SINGLE PROPORTION COUNTY SURVEY NO. 95-060-B &


CORNER FORM NO. T13-95-060-B

MONUMENT DETAIL

Found Set

BASIS OF BEARINGS, NAD 83/91 OREGON STATE PLANE
COORDINATES NORTH ZONE:

NORTHING: 780105.22
EASTING: 8537613.45

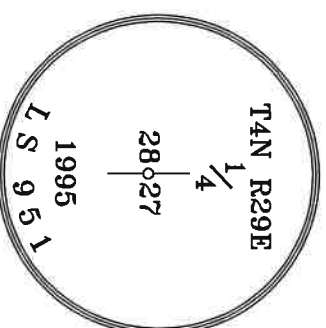

Monument & Accessories Set/Found (Procedure and Description)

AT CORNER FOUND A 2 2/8" BRASS CAP 1" BELOW GRADE & UMATILLA MON. SIGN, COUNTY SURVEY NO.

95-060-B & CORNER FORM NO. T13-95-060-B

FOUND A ALUMINUM TAG 951 ON LIGHT POLE S 08°28' W 110.62', CORNER FORM NO. T13-95-060-B


FOUND A ALUMINUM TAG 951 ON POWER POLE S 70°53' W 28.03', CORNER FORM NO. T13-95-060-B

FOUND A 5/8" IRON ROD W/YELLOW PLASTIC CAP 951 N 00°38' W 16.53', CORNER FORM NO. T13-95-060-B

FOUND A 1/2"X24" IRON ROD W/YELLOW PLASTIC CAP 951 N 89°03' E 13.34', CORNER FORM NO.

T13-95-060-B

Sketch of Monument, Accessories and General Area

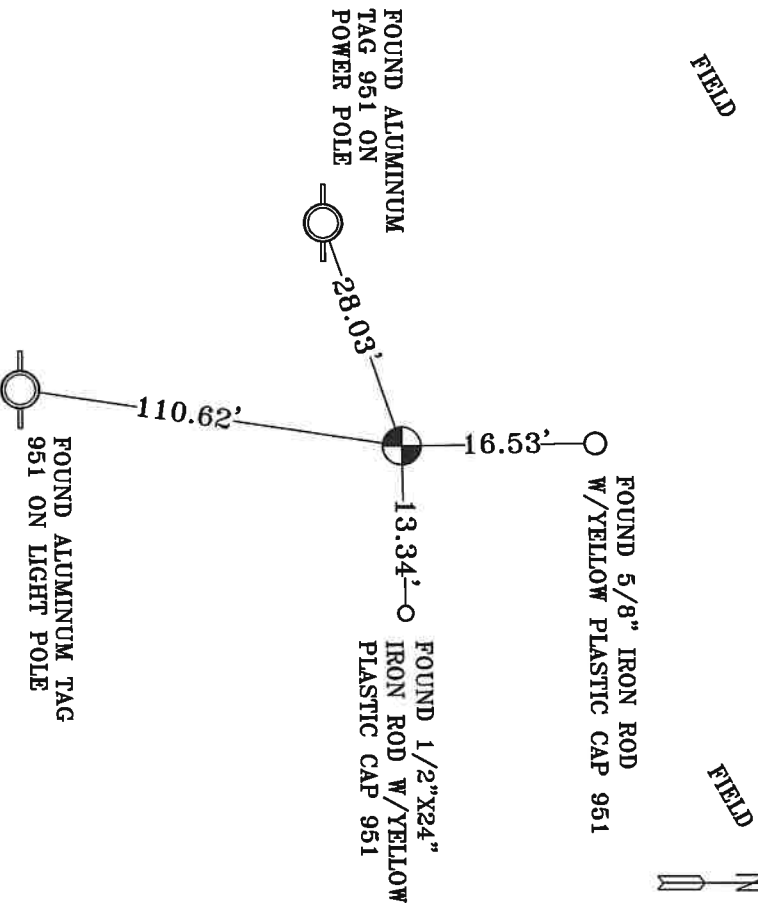

**REGISTERED
PROFESSIONAL
LAND SURVEYOR**

OREGON
MAY 10, 2011
LANCE CLARK KING
61420

RENEWALS: 6/30/2023

Agency: **CK3, LLC**
945 W. ORCHARD
HERMISTON OREGON 97838
OFFICE: 541-567-2345
FAX: 541-567-2305
WEB: CK3ILC.NET
Field Book # 0-350

COUNTY SURVEYOR
RECORDING INFO

Received CT

Filed 5/4/23

Survey No. 23-042-C

Drawing No. _____

Index No. T-13