

CORNER RESTORATION FORM

Township 4N Range 29E Section 26, 27 County UMATILLA

State OREGON Date 3/30/2023 Number T-17

Corner Designation : 1/4 CORNER: 26, 27

Condition Report Only

Not Found

Renewed

Surveyed In

Referenced

Previous Renewals ORIGINAL SOURCE OF CORNER

ORIGINALLY SURVEYED IN 1861 BY DAVENPORT UNDER

CONTRACT #101, HE SET A STAKE IN MOUND OF EARTH

1998 EDWARDS SET A 5/8"X24" I.R. W/2" ALUM. CAP INSIDE

2" I.P. UNKNOWN ORIGIN, COUNTY SURVEY NO. 98-213-C &

CORNER FORM NO. T17-98-213-C


MONUMENT DETAIL

Found Set

BASIS OF BEARINGS, NAD 83/91 OREGON STATE PLANE
COORDINATES NORTH ZONE:

NORTHING: 780251.13

EASTING: 8542890.29

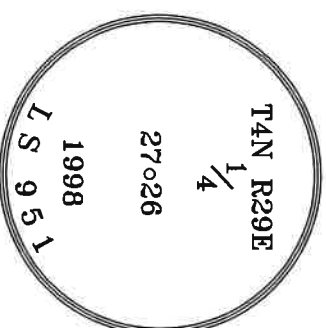

Monument & Accessories Set/Found (Procedure and Description)

AT CORNER FOUND A 2" ALUMINUM CAP 2" BELOW GRADE IN ROAD, COUNTY SURVEY NO. 98-213-C

FOUND A ALUMINUM TAG 951 ON POWER POLE & UMATILLA MON. SIGN S 38°27' W 25.96', CORNER FORM NO. T17-98-213-C

T17-98-213-C


FOUND A ALUMINUM TAG 951 ON TELEPHONE POLE S 41°13' E 28.42', CORNER FORM NO. T17-98-213-C

FOUND A 5/8" IRON ROD NO CAP N 43°26' W 63.72', CORNER FORM NO. T17-01-213-G

FOUND A ALUMINUM TAG 951 ON RAILROAD THE GATE POST N 86°24' E 18.70', CORNER FORM NO. T17-98-213-C

T17-98-213-C

Sketch of Monument, Accessories and General Area

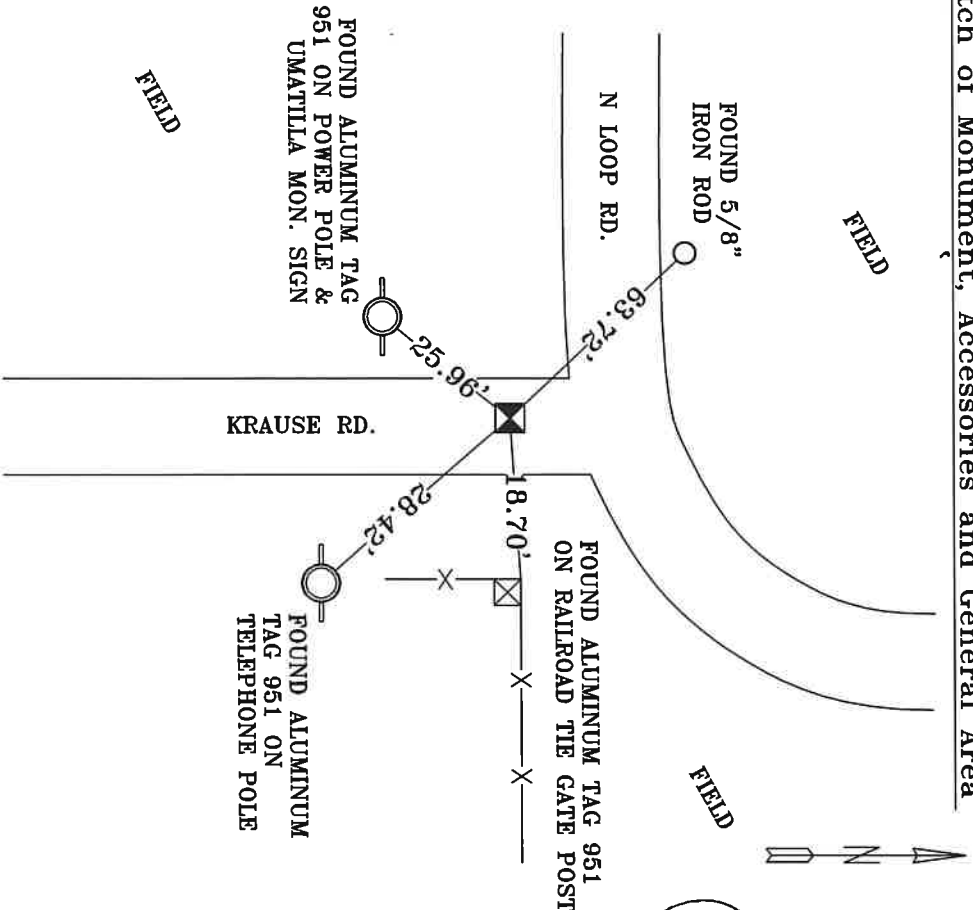

**REGISTERED
PROFESSIONAL
LAND-SURVEYOR**

OREGON
MAY 10, 2011
LANCE CLARK KING
61420

RENEWALS: 6/30/2023

Agency: **CK3, LLC**
945 W. ORCHARD
HERMISTON OREGON 97838
OFFICE: 541-567-2345
FAX: 541-567-2305
WEB: CK3LLC.NET
Field Book # 0-350

COUNTY SURVEYOR
RECORDING INFO

Received CT

Filed 5/4/23

Survey No. 23-042-C

Drawing No. _____

Index No. T-17