

# CORNER RESTORATION FORM

Township 4N Range 29E Section 25, 26 County UMATILLA

State OREGON Date 3/30/2023 Number T-21

Condition Report Only

Corner Designation : 1/4 CORNER: 25, 26

Not Found  
 Renewed

Previous Renewals ORIGINAL SOURCE OF CORNER

Surveyed In  
 Referenced

ORIGINALLY SURVEYED IN 1861 BY DAVENPORT UNDER

CONTRACT #101, HE SET A STAKE IN MOUND OF EARTH


### MONUMENT DETAIL

Found  Set

1998 EDWARDS SET A 1"X30" I.P. W/ 2-3/8" BRASS CAP BY

SINGLE PROPORTION COUNTY SURVEY NO. 98-213-C &

CORNER FORM NO. T21-98-213-C

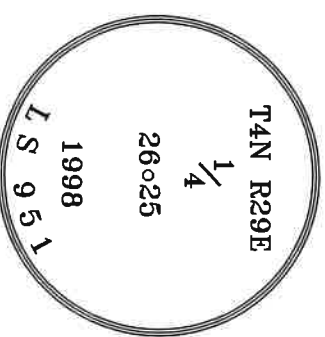

BASIS OF BEARINGS, NAD 83/91 OREGON STATE PLANE  
COORDINATES NORTH ZONE:

NORTHING: 780346.39  
EASTING: 8548199.53

Monument & Accessories Set/Found (Procedure and Description)

AT CORNER FOUND A 1"X30" I.P. W/ 2-3/8" BRASS CAP 2" BELOW GRADE, COUNTY SURVEY NO. 98-213-C  
& CORNER FORM NO. T21-98-213-C


FOUND A 5/8" IRON ROD W/PLASTIC CAP 951 S 89°22' E 67.84', CORNER FORM NO. T21-98-213-C

FOUND A 4" ALUMINUM IRRIGATION STAND PIPE N 85°49' W 51.99', CORNER FORM NO. T21-98-213-C

FOUND A ALUMINUM TAG 951 IN POWER POLE & SET UMATILLA MON. SIGN N 72°10' E 64.72', CORNER FORM NO. T21-98-213-C

FOUND A 5/8" IRON ROD NO CAP S 00°32' W 85.83', CORNER FORM NO. T21-98-213-C

Sketch of Monument, Accessories and General Area

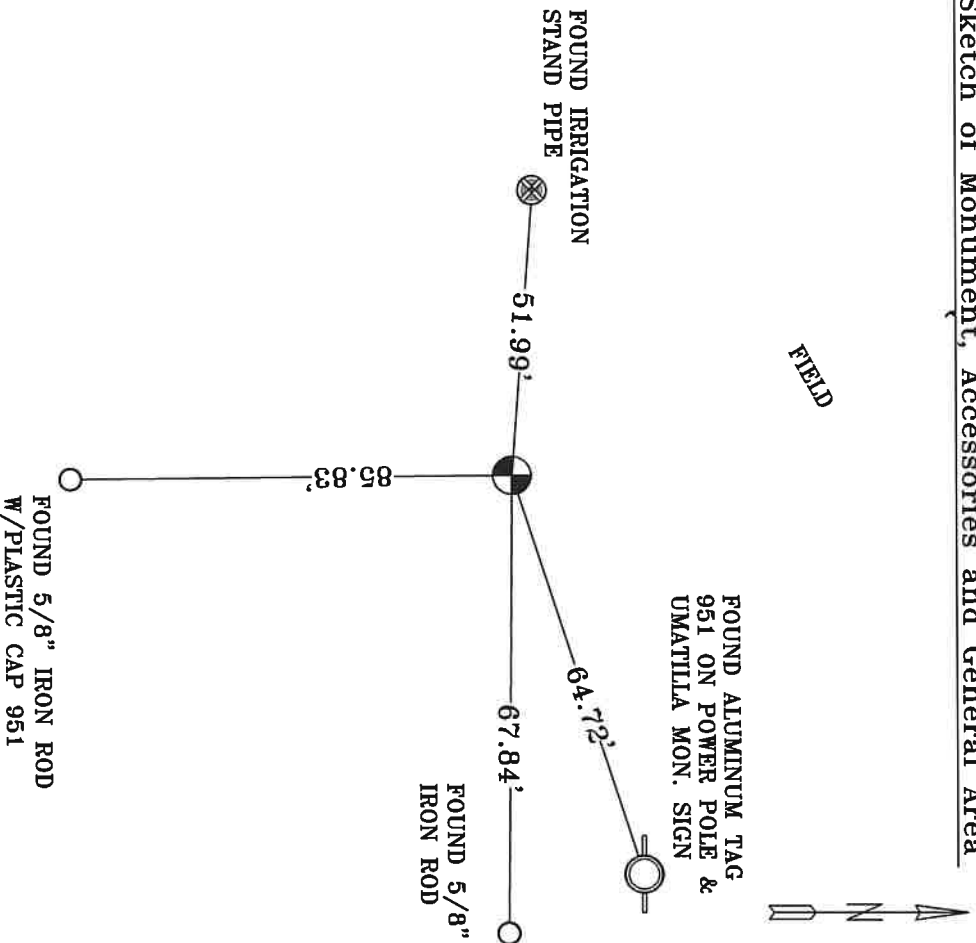

**REGISTERED  
PROFESSIONAL  
LAND SURVEYOR**

OREGON  
MAY 10, 2011  
LANCE CLARK KING  
61420

RENEWALS: 6/30/2023

Agency: CK3, LLC  
945 W. ORCHARD  
HERMISTON OREGON 97838  
OFFICE: 541-567-2345  
FAX: 541-567-2305  
WEB: CK3LLC.NET  
Field Book # 0-350

COUNTY SURVEYOR  
RECORDING INFO

Received CT

Filed 5/4/23

Survey No. 23-042-C

Drawing No. \_\_\_\_\_

Index No. T-21