

OREGON CORNER RESTORATION FORM

SECTION 35 TOWNSHIP 4. NORTH RANGE 29 EAST X-21
 COUNTY : UMATILLA DATE 8-98

CORNER DESIGNATION

E 1/4

CONDITION REPORT ONLY
 NOT FOUND
 RENEWED
 UNCOVERED
 SURVEYED IN
 REFERENCED


PREVIOUS RENEWALS / SURVEYS, ETC.

ORIGINALLY SURVEYED IN 1861 BY DAVENPORT UNDER CONTRACT #101. HE SET A POST IN A MOUND OF EARTH AND A CHARRED STAKE.


MONUMENTS AND ACCESSORIES FOUND: CONDITION AND SOURCE

NOTHING

MONUMENT DETAIL

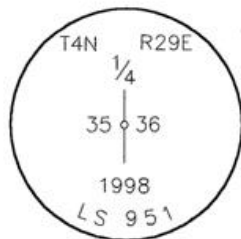

SKETCH

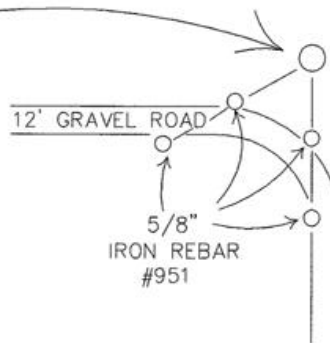

MONUMENT SET (PROCEDURES AND DESCRIPTION)

BY SINGLE PROPORTION I SET A 1" X 30" IRON PIPE WITH A 2 3/8" BRASS CAP STAMPED AS ABOVE, 20" BELOW THE SURFACE OF A CULTIVATED FIELD.

NEW ACCESSORIES FROM WHICH

A 5/8" X 30" IRON REBAR WITH PLASTIC CAP #951 LIES S 78°.04'43" W, 90.93 FEET.
 A 5/8" X 30" IRON REBAR WITH PLASTIC CAP #951 LIES S 78°.04'43" W, 140.64 FEET.
 A 5/8" X 30" IRON REBAR WITH PLASTIC CAP #951 LIES S 7°.42'20" E, 88.71 FEET.
 A 5/8" X 30" IRON REBAR WITH PLASTIC CAP #951 LIES S 7°.42'20" E, 192.22 FEET.

LOCATION AND COMMENTS

COMPASS DEC.

SURVEYOR'S SEAL

FIRM/AGENCY
 EDWARDS SURVEYING
 P.O. BOX 763
 HERMISTON, OREGON 97838
 97838

PARTY CHIEF
 D. EDWARDS

NOTES

WITNESS
 RICK SMITH

RECEIVED BY

Umatilla County Surveyor

Date 10-98

Rec'd By KK

No. 98-213-C

REGISTERED
PROFESSIONAL
LAND SURVEYOR

G. Dennis Edwards

OREGON
 JULY 16, 1971
 G. DENNIS EDWARDS
 951
 RENEWS 12/31/99