

OREGON CORNER RESTORATION FORM

Section 2 Township 3N Range 29E
 County Umatilla Date: 05-09-02

Corner Designation: 3N29A19

_____ Condition Report Only
 _____ Not Found
 _____ Remonumented
 _____ Unrecorded
 _____ x _____ Surveyed In
 _____ Referenced Out

Previous Renewals / Surveys, etc.



Monument set by survey 98-213-C.

Monument and Accessories Found: (condition and source)

Found the 2 1/2" brass capped monument in good condition stamped as shown in the diagram.

SKETCH

DIAGRAM

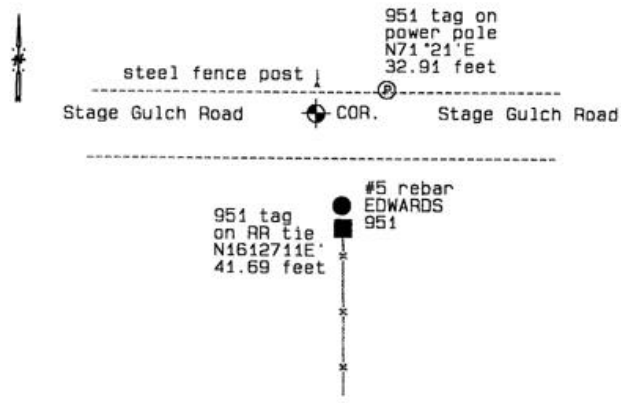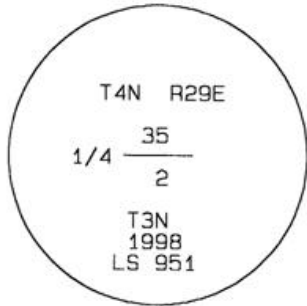

MONUMENT (S) AND ACCESSORIES SET (Procedures and Description)

None.

REFERENCES SET:

None.

Made GPS tie to TRI Station Echo.	Oregon State Plane Coord. - North Zone
Latitude 45°46'38.26567"N	Northing 772358.58
Longitude 119°09'11.82527"W	Easting 8545698.03
NAD 83(1991)	Ortho Height 823.23
	Ellipsoidal Height 753.89

Location and Comments

Compass Declination
20 °E

Surveyors Seal

From junction of S. Ash Road and Stage Gulch Road, go east 2.0 mile.

REGISTERED
PROFESSIONAL
LAND SURVEYOR

RECEIVED BY:

Firm / Agency

David L. Haddock

Date: 6-22
 Rec'd By: KE
 No. 02-169-9

Haddock Surveying
 P. O. Box 1574
 Pendleton, OR 97801
 (541) 276-2174

OREGON
 JULY 12, 1968
 DAVID L. HADDOCK
 852

RENEWS 6-30-03