

OREGON CORNER RESTORATION FORM

Section 31/32/6/5 Township 4N/3N Range 29E
 County UMATILLA Date 8/1/88

A-5

CORNER DESIGNATION

T4N R29E
 S31/S32
 S6/S5
 T3N R29E
 1988
 45 951

- Condition Report Only
- Not Found
- Renewed
- Unrecorded
- Surveyed In
- Referenced Out


Previous Renewals/Surveys, etc. Corner originally established by N.H. Gates under Contract # 84, July 1859. He set a post in earth mound & no bearing trees.

Monument(s) & Accessories Found: (Condition and Source)

Harris found an Iron Pipe in 1972.
I found 1 1/2" outside diameter iron pipe. Very rusty & flush with ground. Also found 1 1/2" x 3" very rusty pipe with B.C. Umatilla Co Surveyor, no date, cemented inside. It was lying on a fence brace post.

Monument Detail

Sketch

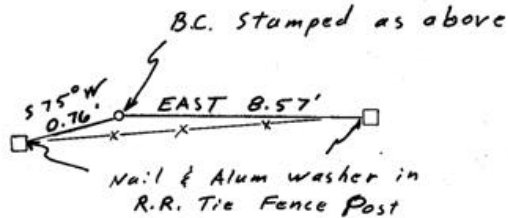

Monument Set (Procedures and Description)

I removed rusty 1 1/2" I. Pipe & replaced with a 1" x 30" flaired Btm Iron Pipe with a B.C stamped as above. I deposited old iron pipe beside & gave 3" top to Co Surveyor.

New Accessories

From which:
a nail & alum. washer in R.R. Tie Fence Post
Bears S 75° W 0.76 Feet
a nail & alum washer in R.R Tie Fence Post
Bears EAST 8.57 Feet

Location & Comments

300' West of Umatilla Compass Declination 20 1/2°
River in Fenceline Firm/Agency Edwards
South of Farm Surveying
Out buildings Address P.O. Box 763
 RECEIVED BY Hermiston, OR
Umatilla County Surveyor Party Chief J. Edwards
 Date 8-88 Notes _____
 Rec'd By [Signature] Witness Rick Smith
 No. 88-55-R

Surveyor's Seal

