

CORNER RESTORATION FORM

Township 3N, 4N Range 29E Section 4,5,32,33 County UMATILLA

State OREGON Date 3/30/2023 Number Z-9

Condition Report Only

Corner Designation : SECTION CORNER: 4, 5, 32, 33

Not Found
 Renewed

Previous Renewals ORIGINAL SOURCE OF CORNER

Surveyed In
 Referenced

ORIGINALLY SURVEYED IN 1859 BY GATES HE SET A POST IN MOUND OF EARTH

MONUMENT DETAIL


1984 KRUMBEN SET A 2 1/2" I.P. W / 2 1/2" B.C. COUNTY

Found Set

SURVEY NO. 84-113-B

BASIS OF BEARINGS, NAD 83/91 OREGON STATE PLANE
COORDINATES NORTH ZONE:


NORTHING: 772036.37
EASTING: 8532497.64

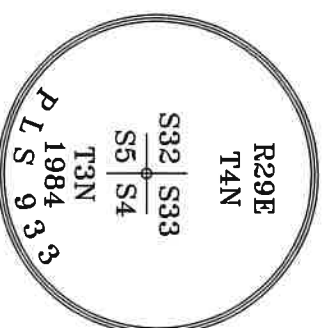

Monument & Accessories Set/Found (Procedure and Description)

AT CORNER FOUND A 2 1/2" BRASS CAP IN MON. BOX, COUNTY SURVEY NO. 84-113-B
 FOUND A 1 1/2" IRON PIPE NO CAP BENT NORTHEAST TIED AT BEND S 51°58' W 35.02', PER CORNER FORM
 NO. Z9-91-061-R, Z9-95-060-B, Z9-09-015-R, & Z9-11-008-R
 FOUND A 2 1/2" BRASS CAP WITNESS CORNER 951 & SET UMATILLA MON. SIGN N 45°52' W 38.04', PER
 CORNER FORM NO. Z9-91-061-R, Z9-95-060-B, Z9-09-015-R, & Z9-11-008-R
 FOUND A ALUMINUM TAG 951 IN POWER POLE N 25°24' E 43.42', CORNER FORM NO. Z9-95-60-B
 FOUND A NAIL & WASHER 43406 ON POWER POLE S 15°55' E 83.72, CORNER FORM NO. Z9-11-008-R &
 Z9-09-15-R

Sketch of Monument, Accessories and General Area

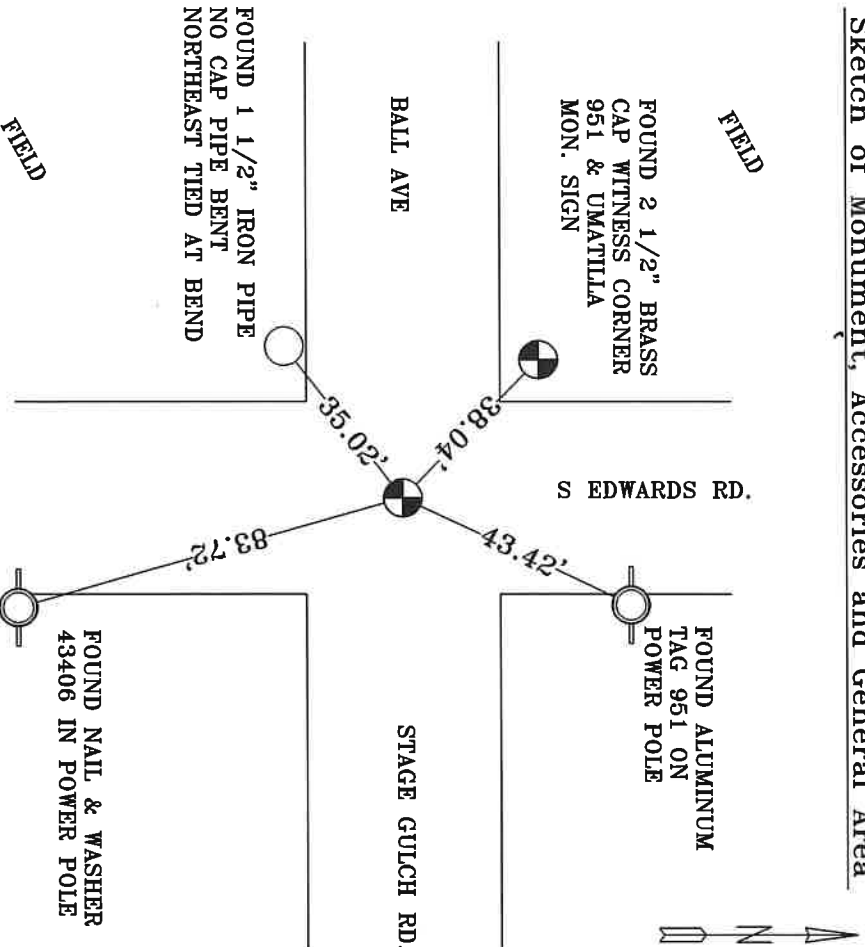

**REGISTERED
PROFESSIONAL
LAND SURVEYOR**

OREGON
MAY 10, 2011
LANCE CLARK KING
61420

RENEWALS: 6/30/2023

Agency: **CK3, LLC**
945 W. ORCHARD
HERMISTON OREGON 97838
OFFICE: 541-567-2345
FAX: 541-567-2305
WEB: CK3LLC.NET
Field Book # 0-350

COUNTY SURVEYOR
RECORDING INFO

Received CT
Filed 5/4/23

Survey No. 23-042-C

Drawing No. _____
Index No. Z-9