

OREGON CORNER RESTORATION FORM

Section 24 Township 4N Range 30E
 County UMATILLA Date 5/26/04

CORNER DESIGNATION

R-21
 (SOUTHWEST CORNER)

- Condition Report Only
- Not Found
- Renewed
- Unrecorded
- X Surveyed In
- X Referenced Out

Previous Renewals/Surveys, etc.:

DOLPHUS PAYNE, UNDER CONTRACT NO. 100, DATED AUGUST 1, 1861, SET CHARRED STAKE WITH MOUND, TRENCH, AND PITS.


Monument(s) & Accessories Found: (Condition and Source)

NONE

Monument Detail

- SET RR SPIKE STAMPED "LS2627" WITH PUNCH MARK
- SET 5/8" X 30" IRON REBAR WITH YELLOW PLASTIC CAP MARKED "UCPWD...LS2627"

Sketch

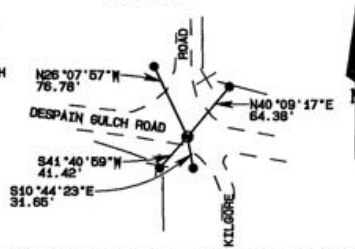

Monument Set (Procedures and Description):

SET A RAILROAD SPIKE STAMPED "LS2627" WITH PUNCH MARK FLUSH WITH THE PAVED SURFACE OF DESPAIN GULCH ROAD BY DOUBLE PROPORTION BETWEEN THE SOUTHWEST CORNER OF SECTION 23 TO THE WEST AND THE SOUTHWEST CORNER OF SECTION 24 TO THE EAST (BOTH SET IN THIS SURVEY) AND THE INTERSECTION OF AN EAST-WEST FENCE AND KILGORE ROAD (OLD COUNTY ROAD NO. 198 ESTABLISHED ALONG THE SECTION LINE) 1 MILE NORTH AND THE INTERSECTION OF KILGORE ROAD (OLD ROAD NO. 198) AND AN EAST-WEST PLOW LINE 1 MILE SOUTH.

New Accessories:

- A 5/8" X 30" IRON REBAR WITH YELLOW PLASTIC CAP MARKED "UCPWD...LS2627" BEARS N26°07'57"W, 76.78'.
- A 5/8" X 30" IRON REBAR WITH YELLOW PLASTIC CAP MARKED "UCPWD...LS2627" BEARS N40°09'17"E, 64.38'.
- A 5/8" X 30" IRON REBAR WITH YELLOW PLASTIC CAP MARKED "UCPWD...LS2627" BEARS S10°44'23"E, 31.65'.
- A 5/8" X 30" IRON REBAR WITH YELLOW PLASTIC CAP MARKED "UCPWD...LS2627" BEARS S41°40'59"W, 41.42'.

Location and Comments: Compass Declination: N/A

Surveyor's Seal

CORNER IS LOCATED IN THE SOUTH TRAVEL LANE OF DESPAIN GULCH ROAD AT ITS INTERSECTION WITH KILGORE ROAD APPROXIMATELY 6 1/2 MILES EAST OF ITS INTERSECTION WITH NORTH LOOP ROAD.

Firm/Agency :
 UMATILLA COUNTY
 ROAD DEPARTMENT
 Address:
 3920 WESTGATE
 PENDLETON, OREGON
 Party Chief:
 GARY ROBERTS
 Notes:
 GARY ROBERTS
 Witness:
 NONE

REGISTERED
 PROFESSIONAL
 LAND SURVEYOR

Gary R. Roberts
 OREGON
 JULY 20, 1993
 GARY R. ROBERTS
 2627
 RENEWS 12/31/2004