

CORNER RESTORATION FORM

Township 3N & 4N Range 30E Section 3,4,33&34 County UMATILLA

State OREGON Date 5-6-2015 Number A-13

Corner Designation : SECTION 3, 4, 33 & 34

Condition Report Only
 Not Found
 Renewed
 Surveyed In
 Referenced

Previous Renewals ORIGINAL SOURCE OF CORNER

UNDER GLO CONTRACT #84 BY N. GATES DATED
JULY 22, 1859 SET POST
BRASS CAP PER SURVEY I-162-B (NOT FOUND)

Accessories Found:


5/8" REBAR & CAP L.S. 951 NO RECORD OF MONUMENT AT
LOCATION OF SET BRASS. REMOVED 5/8" AT REQUEST OF
MR. EDWARDS

BASIS OF BEARINGS, NAD 83/91 OREGON STATE PLANE
COORDINATES NORTH ZONE:

NORTHING: 772842.953
EASTING: 8570026.565

MONUMENT DETAIL

Found Set

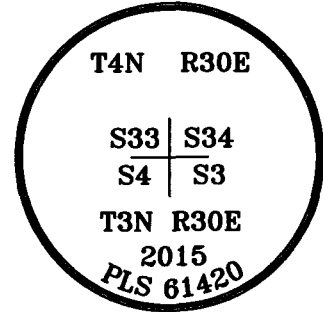

Monument & Accessories Set (Procedure and Description)

- SET 2 1/2" BRASS CAP ON 1 1/4"x30" PIPE 0.1' BELOW GRADE, 4'± NORTH OF EDGE OF GRAVEL ROAD,
- SET SURVEY MARKER SIGN ON GREEN STEEL POST.
- SET 5/8" REBAR & CAP PLS 61420 AT GRADE, SET BEARING OBJECT SIGN ON GREEN STEEL POST, S74°25'E
- 43.80'.
- SET 5/8" REBAR & CAP PLS 61420 AT GRADE, SET BEARING OBJECT SIGN ON WOOD POST, S2°31'W 64.25'.
- SET 5/8" REBAR & CAP PLS 61420 AT GRADE IN FENCE LINE, S79°44'W 76.92'.
- SET 5/8" REBAR & CAP PLS 61420 AT GRADE, N63°51'W 74.77'.

<p>Sketch of Monument, Accessories and General Area</p>	<div style="border: 1px solid black; padding: 5px; text-align: center;"> <p>REGISTERED PROFESSIONAL LAND SURVEYOR</p> <p><i>Lance Clark King</i></p> <p>OREGON MAY 10, 2011 LANCE CLARK KING 61420</p> </div> <p>RENEWS: 6/30/2017</p> <p>Agency: CK3, LLC 945 W. ORCHARD HERMISTON OREGON 97838 OFFICE: 541-567-2345 FAX: 541-567-2305 WEB: CK3LLC.NET Field Book # 0-298</p> <hr/> <p>COUNTY SURVEYOR RECORDING INFO</p> <p>Received <i>Jay Robert</i></p> <p>Filed <u>6/12/2015</u></p> <p>Survey No. <u>15-050-C</u></p> <p>Drawing No. <u>C-853</u></p> <p>Index No. <u>A-13</u></p>
--	---