

**OREGON CORNER RESTORATION FORM**

COUNTY: Umatilla. DATE: 10/02/18.

CORNER DESIGNATION: G-9, The East 1/4 corner of Section 8, Township 4 North, Range 33 East, W.M.

PREVIOUS RENEWALS/SURVEYS ETC: Corner was originally established by Odell and Lewis, Deputy Surveyors, under Contract No. 110, dated February 7, 1865. Notes state:

Set 1/4 Sec. post. Drove charred stake. Dug pits and raised mound as per instructions.

MONUMENT AND ACCESSORIES FOUND: None. Reestablished corner point at the intersection field berms extending East-West and South. There is an old down fence corner at this location.

**MONUMENT MARKING DETAIL:**

T4N R33E  
1/4  
S8 | S9  
2018  
PLS 1106

MONUMENT SET: Set a 2 3/8" brass cap on 1 1/4" galvanized iron pipe 30" in the ground. Cap marked as shown in Monument Marking Detail.

**New accessories:**

- A 5/8" by 24" rebar with red plastic cap bears S 88° W, 18.3'.
- A 5/8" by 24" rebar with red plastic cap bears S 80° E, 18.8'.
- A 5/8" by 24" rebar with red plastic cap bears S 05° W, 25.6'.
- A 5/8" by 24" rebar with red plastic cap bears S 42° W, 12.7'.


Red plastic caps are marked "ORPLS 1106 W/APLS 17372". All rebar accessories have "bearing object" signs wired to them.

Set steel fence post 2' West of corner and attached "Witness" sign.

LOCATION AND COMMENTS: Corner is located at the intersection of old field berms extending East-West and South by old down fence corner. No fence remains are visible extending from the corner.

FIRM: Wells Surveying  
P.O. Box 1696  
Pendleton, OR 97801

Surveyor's Seal

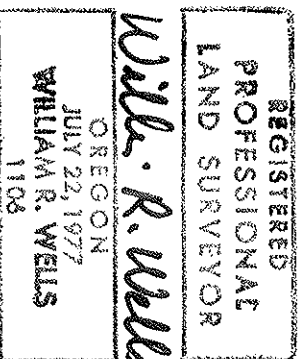

14N33G-9

**RECEIVED BY**  
Umatilla County Surveyor  
Date: 10/11/2018  
Rec'd By: JMA  
No.: 18-087-R