

**OREGON CORNER RESTORATION FORM**

COUNTY: Umatilla. DATE: 10/05/18.

CORNER DESIGNATION: L-5, The East 1/4 corner of Section 18, Township 4 North, Range 33 East, W.M.

PREVIOUS RENEWALS/SURVEYS ETC: Corner was originally established by Odell and Lewis, Deputy Surveyors, under Contract No. 110, dated February 7, 1865. Notes state:

Set 1/4 Sec. Post, drove charred stake. Dug pits and raised mound as per instructions.

MONUMENT AND ACCESSORIES FOUND: None. Reestablished corner on line between the Southeast and Northeast corners of Section 18 at intersection of an East-West field line.

**MONUMENT MARKING DETAIL:**

T4N R33E  
1/4  
S18 | S17  
2018  
PLS 1106

MONUMENT SET: Set a 2 3/8" brass cap on 1 1/4 by 30" galvanized iron pipe 30 inches in the ground. Cap marked as shown in Monument Marking Detail.

**New accessories:**

- A silver Deep 1 magnet bears N 89°E, 35.0'.
- A purple Deep 1 magnet bears N 89°E, 20.1'.
- A blue Deep 1 magnet bears N 88°W, 14.8'.
- A orange Deep 1 magnet bears N 88°W, 29.3'.

Deep 1 magnets are buried 15" below ground line. "Bearing object" signs are buried beside each Deep 1 magnet.

Set steel fence post 1.5' East of corner and attached "Witness" sign.


LOCATION AND COMMENTS: Corner is located in a East-West field line. A crooked field line extends South, beginning about 600' South of corner monument.

FIRM: Wells Surveying

P.O. Box 1696  
Pendleton, OR 97801

Surveyor's Seal

IAN33L-5

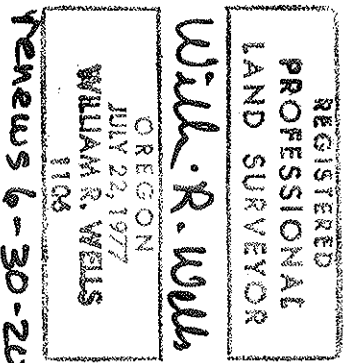

Renews 6-30-20

**RECEIVED BY**  
 Umatilla County Surveyor  
 Date: 10/11/2018  
 Recd BY: TMA  
 No.: 18-087-R