

OREGON CORNER RESTORATION FORM

Section: 1, 2, 35, 36 Township: 3N, 4N Range: 33E
County: Umatilla Date: 3/23/2011

Corner Designation: 3N33A21

Section corner common to Sections 1,2, T3NR33E; 35, 36, T4NR33E.

_____	Condition Report Only
_____	Not Found
X	Remonumented
_____	Unrecorded
_____	Surveyed In
X	Referenced Out


Previous Renewals / Surveys, etc.

Originally surveyed by Thompson in 1864. He set a post in a mound of earth with charred stake, pits, and trench. In 1976 Krumbein set a PK nail and brass cap witness corners.


Monuments and Accessories Found: (Condition and Source):

A PK nail at the corner location.
A brass cap witness corner, stamped as shown below, lies N 1° 50' W, 30.15'.
A brass cap witness corner, stamped as shown below, lies S 2° 30' E, 29.72'.

Diagram

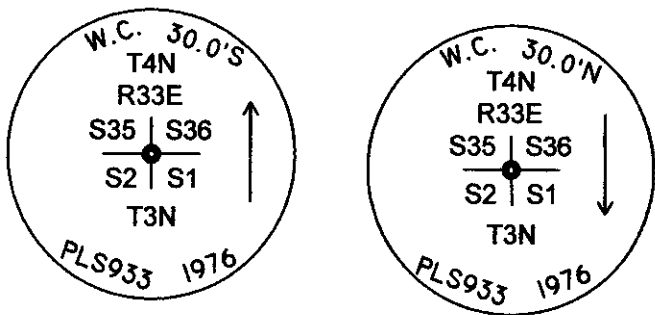

Sketch

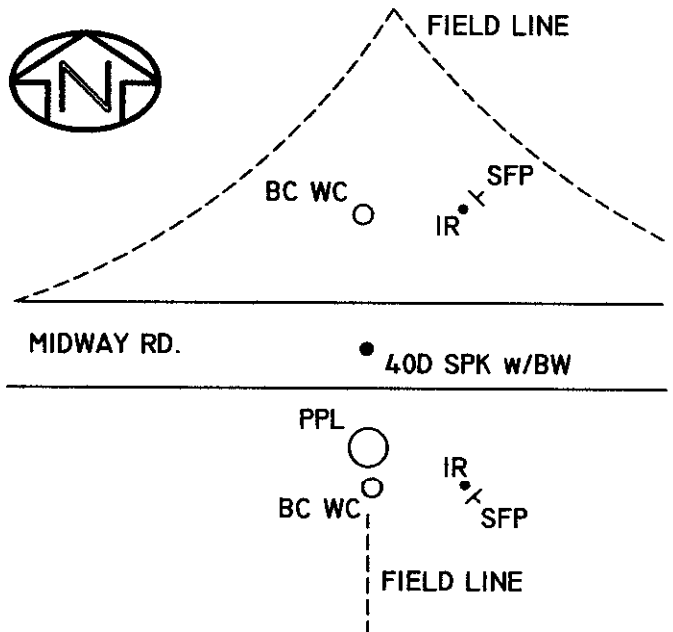

NAD 83/91
OREGON STATE PLANE NORTH
INTERNATIONAL FEET

N774420.75
E8675940.09

Monument(s) Set (Procedures and Description):

A 40D spike with a brass washer was set, 2" below the surface, in place of the existing PK nail.

References Set:

A 5/8" x 30" iron rebar w/RPC #43406 lies N 50° 30' E, 35.30', with a steel fence post.
A 5/8" x 30" iron rebar w/RPC #43406 lies S 45° 30' E, 28.32', with a steel fence post.

Location and Comments:

The corner is located 1/2 mile East of the intersection of Midway Rd. and the Helix Hwy.

Compass Declination

17° E

Surveyors Seal

REGISTERED
PROFESSIONAL
LAND SURVEYOR

Robert D. English
OREGON
JANUARY 11, 2005
ROBERT DOUGLAS ENGLISH
43406LS

RENEWAL DATE: 12/31/13

RECEIVED BY:

Firm / Agency

Date: 7/10/2012
Rec'd By: S. Oles
No. 12-094-C

Survey One, LLC.
P.O. Box 382
Pendleton, OR 97801
(541) 276-2055