

OREGON CORNER RESTORATION FORM

Section 31,32,5,6

Township 3N,4N

Range 33E

County Umatilla

Date: 03/24/11

Corner Designation: 3N33A5

Section Corner

- Condition Report Only
- Not Found
- Remonumented
- Unrecorded
- Surveyed In
- Referenced Out


Previous Renewals / Surveys, etc.

Originally Surveyed by Thompson in 1864. He set a post in a mound of earth.


Monuments and Accessories Found: (Condition and Source)

None.

Diagram

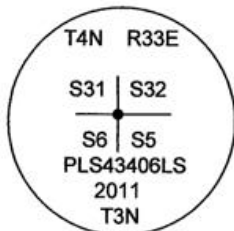

Sketch

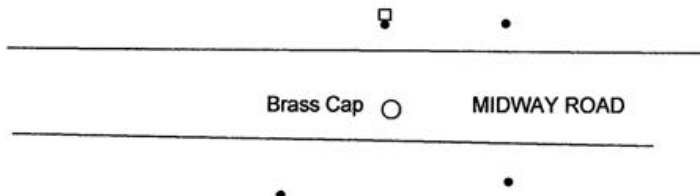

NAD 83/91
OREGON STATE PLANE NORTH
INTERNATIONAL FEET

N773969.71
E8654807.65

Monument (s) Set (Procedures and Description)

A 1 1/4" x 30" galvanized iron pipe with a 2 1/2" brass cap, stamped as shown above, 12" below the surface. There are railroad tie posts every half mile that have been held as boundary lines as evidenced by field lines. I find this to be the best available evidence of the original corner position for Easting locations.

References Set: "Deep One" magnets by Berntsen.

- A 5/8" x 30" iron rebar w/rpc #43406, lies N 0°20' W, 16.94', at a RR Tie.
- A Silver magnet, 17" deep, lies N 45° E, 21.58'.
- A Pink magnet, 18" deep, lies S 29° E, 30.76'.
- A Blue magnet, 20" deep, lies S 34°50' W, 33.97'.

Location and Comments

The corner is 0.5 miles West of the intersection of Myrick Road and Midway Road, in Midway Road.

Compass Declination
17° E

Surveyors Seal

REGISTERED
PROFESSIONAL
LAND SURVEYOR

Robert D. English
OREGON
JANUARY 11, 2005
ROBERT DOUGLAS ENGLISH
43406LS

RECEIVED BY:

Date: _____
Rec'd By: _____
No. _____

Firm / Agency

Survey One, LLC.
P.O. Box 382
Pendleton, OR 97801
(541) 276-2055

RENEWAL DATE: 12/31/11