

OREGON CORNER RESTORATION FORM

Section 13 Township 4N Range 36E
 County Umatilla Date: November 3, 2005

Corner Designation: 4N36J23

Quarter corner to sections 12 and 13, T4N, R36E,
 W.M., Umatilla County, Oregon.



Previous Renewals / Surveys, etc.

Corner originally set by William H. Odell under contract No. 114 dated July 2, 1866. His record reads: Set basalt stone 5 x 9 x 14, Cor for 1/4 Sec.

Condition Report Only

Not found
 Remonumented
 Unrecorded
 Surveyed in
 Referenced out

Monument and Accessories found: (condition and source)
 None.

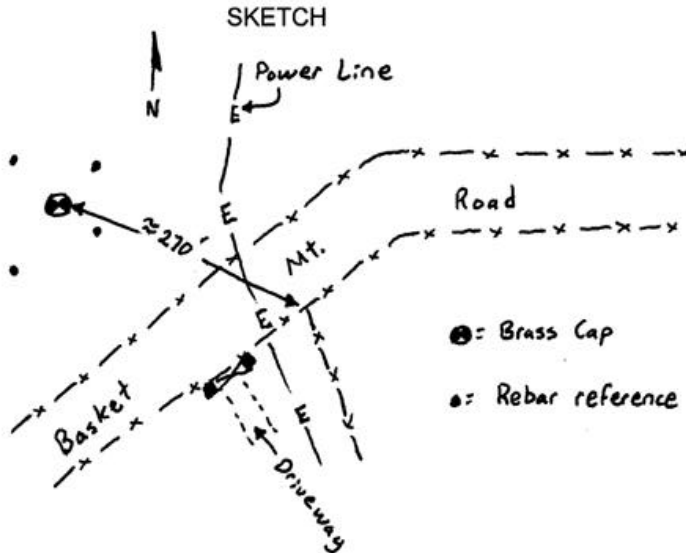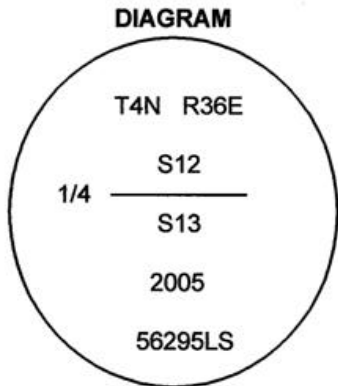

MONUMENT (S) AND ACCESSORIES SET (Procedures and Description)

At the proportionate point I set a 1 1/4" x 30" galvanized iron pipe with a 2 3/8" brass cap stamped as shown in the diagram above 12" in the ground to bedrock. I raised a mound of earth and stone 4' diameter to the top of the cap.

For references, I set four 5/8" by 18" rebars with 1 1/8" orange plastic caps stamped WTS and 56295LS as described below:

- an iron rebar bears N37°47'22"W, 104.43 feet;
- an iron rebar bears S61°18'41"E, 24.85 feet;
- an iron rebar bears S56°07'40"W, 75.37 feet;
- an iron rebar bears N40°55'35"E, 34.56 feet;

The monument was set and references tied using a Trimble R7/R8 RTK GPS.

Location and comments

Compass Declination

Surveyors Seal

RECEIVED BY:
Umatilla County Surveyor
 Date: 11-05
 Rec'd By: KK
 No. 05-198-C

Firm / Agency
 Witness Tree Surveying
 Address
 P.O. Box G
 Pilot Rock, Or. 97868
 Party Chief
 Stephen K, Haddock



Stephen K. Haddock



RENEWAL DATE 6-30-07